

PROJECT EVALUATION AND FINAL REPORT

**KINKAID LAKE TMDL BEST MANAGEMENT PRACTICES
IMPLEMENTATION**

FINANCIAL ASSISTANCE AGREEMENT NO. 3190521

**PROJECTS FUNDED THROUGH ASSISTANCE FROM THE NONPOINT SOURCE
POLLUTION CONTROL PROGRAM, SECTION 319(h)**

Program Administered by the
Illinois Environmental Protection Agency
Division of Water Pollution Control
Springfield, Illinois 62794-9276

Report Submitted by:
Kinkaid-Reed's Creek Conservancy District
1763 Water Plant Road
Murphysboro, Illinois 62966

Prepared by:
HDR | Cochran & Wilken, Inc.
1339 Walnut Street
Murphysboro, Illinois 62966

August 2007

This report was prepared using U.S. Environmental Protection Agency funds under Section 319 of the Clean Water Act distributed through the Illinois Environmental Protection Agency. The findings and recommendations herein are not necessarily those of the funding agencies.

TABLE OF CONTENTS

Project Evaluation and Report, Narrative	Pages 1 - 7
Attachment 1: Project Location Map	Sheet 1
Attachment 2: Construction Cost Detail Sheets	Pages 1 - 4
Attachment 3: Operations and Maintenance Plan	Pages 1 - 6
Attachment 4: Estimated Load Reduction Spreadsheets, Sediment and Nutrients	Pages 1- 6
Attachment 5: Project Pictures	Pages 1 - 8
Attachment 6: As-Built Drawings	
Sediment / Nutrient Detention Basin #1	Sheets 1 – 3
Sediment / Nutrient Detention Basin #2, Gully Stabilization, Shoreline Stabilization	Sheets 1 – 6, 9, 12, 13, 14 (10 total shts.)
Attachment 7: Map of All Shoreline Protection Completed As of August, 2007	Sheet 1
Attachment 8: Public Information and Outreach Material	Packet
Attachment 9: Abstract from presentation by John Severson	Pages 1-3

ATTACHMENT 1
PROJECT LOCATION MAP

ATTACHMENT 2
CONSTRUCTION COST DETAIL SHEETS




5201 South Sixth Street Road, Springfield, IL 62703-5143
1339 Walnut Street, Murphysboro, IL 62966

Project: Kinkaid Lake Section 319 Projects
Shoreline Stabilization
319 funded areas only
Client: KRCCD-2006 & 2007
Phase: Final **Client Proj #:**
By: GWR **CWI Project #:** 05078
Date: 08/14/07

SUMMARY OF FINAL PROJECT COST				
ITEM	NO. UNITS	UNIT MEAS.	COST PER UNIT	TOTAL COST
Stone Riprap, Gradation RR 4 (delivered cost)	8,525.8	Tons	\$13.09	\$111,586.19
Filter Fabric & Hold Down Pins	7,495.0	Feet	\$1.00	\$7,495.00
Loading-unloading area maintenance (per ton of riprap basis)	8,525.8	Tons	\$0.36	\$3,069.56
Shoreline Stabilization, including mobilization, labor, equipment, bonding, overhead and profit (per ton of riprap basis)	8,525.8	Tons	\$33.51	\$285,717.95
SUBTOTAL				\$407,868.70
TOTAL PROJECT COST				\$407,868.70

8525.72

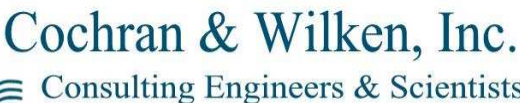

5201 South Sixth Street Road, Springfield, IL 62703-5143
1339 Walnut Street, Murphysboro, IL 62966

Project: Kinkaid Lake Section 319 Projects
Sediment / Nutrient Detention Basin #1

Client: KRCCD

Phase: Final **Client Proj #:**

By: GWR CWI Project #: 05078

Date: 01/05/06

SUMMARY OF FINAL PROJECT COST

	ITEM	NO. UNITS	UNIT MEAS.	COST PER UNIT	TOTAL COST
	Equipment Operator-Laborer (S. Christy)	588.3	Hours	\$34.66	\$20,390.48
	Equipment Operator-Laborer (J. Wohlstadter)	588.3	Hours	\$35.57	\$20,925.83
	Crawler Tractor-Dozer, Cat D-4 XL	326.0	Hours	\$48.65	\$15,859.90
	Crawler Tractor-Dozer, Cat D-6 RXL	150.4	Hours	\$77.90	\$11,716.16
	Crawler Tractor-Dozer, Fiat 11B	259.2	Hours	\$62.30	\$16,148.16
	Crawler Loader, Cat 943	105.5	Hours	\$48.65	\$5,132.58
	Sheepsfoot Compactor, towed unit	22.5	Hours	\$31.60	\$711.00
	Hydraulic Excavator, Gradall	181.5	Hours	\$82.01	\$14,884.82
	Farm Tractor, New Holland 45 H.P.	15.0	Hours	\$11.45	\$171.75
	Farm Tractor, John Deere 33 HP	1.0	Hours	\$9.00	\$9.00
	Farm Tractor, J.D. 5410 & Ford 6610, 70 H.P.	3.0	Hours	\$16.55	\$49.65
	Dump Truck	21.0	Hours	\$25.00	\$525.00
	Service Truck	432.0	Hours	\$20.92	\$9,037.44
	Material, Sch. 80 Stl Pipe, 30"	120.0	Feet	\$110.00	\$13,200.00
	Material, Sch. 40 PVC Pipe, 10"	160.0	Feet	\$28.00	\$4,480.00
	Material, 10" Gate Valve	1.0	Each	\$1,250.00	\$1,250.00
	Materials, seed and fertilizer		Total		\$492.44
	Equipment Mobilization and De-mobilization	1450.0	Miles	\$1.00	\$1,450.00
	SUBTOTAL				\$136,434.20
	Surveying and Engineering				\$10,699.88
	TOTAL PROJECT COST				\$147,134.08



5201 South Sixth Street Road, Springfield, IL 62703-5143
1339 Walnut Street, Murphysboro, IL 62966

Project: Kinkaid Lake Section 319 Projects
Sediment / Nutrient Detention Basin
No. 2 & Shared Borrow Area Completion
Client: KRCCD
Phase: 95% **Client Proj #:**
By: GWR **CWI Project #:** 05078
Date: 11/14/06

SUMMARY OF PROJECT COST at 11/14/2006

	ITEM	NO. UNITS	UNIT MEAS.	COST PER UNIT	TOTAL COST
	Equipment Operator-Laborer (S. Christy)	256.0	Hours	\$34.66	\$8,872.96
	Equipment Operator-Laborer (A. Robison)	256.0	Hours	\$34.66	\$8,872.96
	Crawler Tractor-Dozer, Cat D-4 XL	160.0	Hours	\$48.65	\$7,784.00
	Crawler Tractor-Dozer, Int TD 15	11.0	Hours	\$62.30	\$685.30
	Crawler Tractor-Dozer, Fiat 11B	107.0	Hours	\$62.30	\$6,666.10
	Crawler Loader, Cat 943	28.0	Hours	\$48.65	\$1,362.20
	Sheepsfoot Compactor, towed unit	28.0	Hours	\$31.60	\$884.80
	Hydraulic Excavator, Gradall	52.0	Hours	\$82.01	\$4,264.52
	Farm Tractor, New Holland 45 H.P.	14.0	Hours	\$11.45	\$160.30
	Farm Tractor, J.D. 5410 & Ford 6610, 70 H.P.	7.0	Hours	\$16.55	\$115.85
	Dump Truck	91.0	Hours	\$25.98	\$2,364.18
	Service Truck	185.0	Hours	\$20.92	\$3,870.20
	Material, Anti-seep collars	10.0	Each	\$111.52	\$1,115.20
	Material, Sch. 40 PVC Pipe, 10"	200.0	Feet	\$10.00	\$2,000.00
	Material, 10" Gate Valve	2.0	Each	\$1,127.42	\$2,254.84
	Material, connectors	2.0	Each	\$31.04	\$62.08
	Material, geofabric	300.0	Feet	\$1.33	\$399.00
	Material, silt fence	400.0	Feet	\$0.74	\$296.00
	Materials, seed and fertilizer	1.0	L Sum		\$778.59
	Material, straw mulch	60.0	Bales	\$2.00	\$120.00
	Equipment Rental	1.0	L Sum		\$189.10
	Labor, in-kind by Boy Scouts of America	42.0	Hours	\$10.00	\$420.00
	Equipment Mobilization and De-mobilization	800.0	Miles	\$1.00	\$800.00
	Note: work remaining consists of:				
	A. Corrective erosion repair, seeding and mulching				
	B. Silt fence removal				
	C. Excess earth material removal				
	D. Stone riprap at pipe outlet				
	SUBTOTAL				\$54,338.18
	TOTAL PROJECT COST				\$54,338.18



5201 South Sixth Street Road, Springfield, IL 62703-5143
1339 Walnut Street, Murphysboro, IL 62966

Project: Kinkaid Lake Section 319 Projects
GULLY STABILIZATION

Client: KRCCD

Phase: 95% **Client Proj #:**

By: GWR **CWI Project #:** 05078

Date: 11/14/06

SUMMARY OF PROJECT COST at 11/14/2006

	ITEM	NO. UNITS	UNIT MEAS.	COST PER UNIT	TOTAL COST
	MATERIAL COST (RECEIPTS ON FILE)				
	Materials, lumber products (Wright's Building Ctr)				\$1,070.89
	Stone riprap, 50# size, Kinkaid Stone				\$1,842.00
	Chainsaw chains, maintenance				\$57.98
	Hand tools, fastening materials, Rural King				\$498.99
	Materials, fastenings, True Value Hardware				\$7.98
	Wire, fastenings, hardware, Rural King				\$51.96
	Materials, lumber products (Wright's Building Ctr)				\$451.36
	Materials, geo textile fabric, Energy Culvert Company				\$800.00
	EQUIPMENT				
	Equipment, Bobcat with Hydrocutter, operator	6.5	Hours	\$110.00	\$715.00
	Equipment, Rubber tired backhoe, endloader	75.5	Hours	\$60.00	\$4,530.00
	Equipment, truck and lowboy, equipment mobilization	120.0	Miles	\$4.50	\$540.00
	Equipment, pickup truck with 16' trailer	120.0	Miles	\$1.00	\$120.00
	Equipment, Tractor and bush hog mower	16.0	Hours	\$18.50	\$296.00
	LABOR				
	G. Baird, KRCCD, foreman, laborer	95.5	Hours	\$23.80	\$2,272.90
	M. Dietz, IDNR, foreman, operator	95.5	Hours	\$23.80	\$2,272.90
	S. Wilmouth, KRCCD, operator	75.5	Hours	\$31.35	\$2,366.93
	LABOR, Illinois Dept. of Corrections Personnel	480.0	Hours	\$23.80	\$11,424.00
	Note: remaining work consists of:				
	A. Corrective erosion repair, seeding, mulching				
	B. Construction of one additional stabilization structure, stone construction type 4				
	SUBTOTAL				\$29,318.89
	TOTAL PROJECT COST				\$29,318.89

ATTACHMENT 3
OPERATIONS AND MAINTENANCE PLAN

OPERATIONS AND MAINTENANCE PLAN
FOR
SEDIMENT / NUTRIENT DETENTION BASINS
GULLY STABILIZATION
SHORELINE STABILIZATION

CONSTRUCTED WITH COOPERATION OF THE
ILLINOIS ENVIRONMENTAL PROTECTION AGENCY
NONPOINT SOURCE POLLUTION CONTROL PROGRAM
SECTION 319(H)

KINKAID-REED'S CREEK CONSERVANCY DISTRICT
1763 WATER PLANT ROAD
MURPHYSBORO, ILLINOIS 62966

Prepared by

Cochran & Wilken, Inc.
1339 Walnut Street
Murphysboro, Illinois 62966
March 30, 2006

SEDIMENT / NUTRIENT DETENTION BASINS

1. Impoundment basins are designed to remove sediment and nutrients from concentrated sheet runoff from the watershed area flowing to the basin. This removal process occurs through the storage of such runoff for a period of time sufficient to allow natural settling of such particles prior to discharge of the water which transports these materials. The life of the impounding structures (dam and spillway(s)), should be indefinite with proper maintenance. The expected life of the overall structure as an effective sediment and nutrient removal system will vary, dependent on the management within the watershed and other factors. While it is expected that such basins will perform for at least ten years without sediment removal, it is inevitable that periodic sediment removal will be required.
2. Periodically, and particularly following heavy rainfall, inspect the spillway(s) for possible debris accumulation and erosion. Erosion of the grass-lined emergency spillways should be repaired by filling eroded channels and reseeding. Erosion immediately downstream of the spillway outlets also will require close monitoring. Repair such erosion as soon as possible after occurrence.
3. Maintain vigorous growth of desirable vegetation coverings (sod) in the emergency spillways and on embankments. This includes reseeding, fertilizing, and controlled herbicide applications as required. Periodic mowing should also be done. Time mowing after nesting birds have hatched (about August 15).
4. Maintain a grass filter strip around the perimeter of the basins.
5. Check for and repair damage to embankments by rodents or burrowing animals.
6. Remove woody vegetation from embankments. Prevent trees and brush from growing on embankments, abutments, or in the spillway areas. Control trees and brush by hand cutting, mowing, or chemicals. Avoid grass damage by herbicides and do not burn.
7. Monitor for possible settlement or cracks in the embankment section. Repair as necessary.
8. Inspect the downstream toe of the embankment annually. If there are wet areas or seeps at the downstream toe of the embankment, it could indicate a serious problem. In the event such seepage is present, seek professional assistance to evaluate the seep.

9. Fill all rills and gullies that occur on the embankments and vegetated spillway. Reseed the filled areas.
10. Pipe inlet maintenance: periodically, and especially after periods of heavy rainfall, inspect the principal spillway pipe inlet and the section of the dam on the upstream end of the pipe. Remove all accumulated debris at the pipe inlet and repair any erosion or soil loss on the dam at the upstream pipe entrance. Upon lake drawdown for fish harvest or sediment removal maintenance, inspect the drawdown pipe inlet end for debris or sediment accumulation. Remove all such debris or sediment accumulation to assure this pipe will function at the next lake drawdown.
11. Drawdown pipe valve maintenance: the purpose of this valve is to allow total or partial reduction in lake water level for purposes such as shoreline vegetation management, sediment removal, and fish harvest. Periodically (no less often than once per year) operate this valve to assure the valve will open, close and seat as designed. Repair or replace this valve as necessary.

GULLY STABILIZATION: GRADE STABILIZATION STRUCTURES

1. Grade stabilization structures are designed to reduce gully erosion by reducing the overall gradient of the gully flow line to slow flow velocities to levels that are not erosive to the native soil materials. The structures are designed of materials that can be transported and placed within the active gullies with as little disturbance to the surrounding forested areas as possible. No effort has been made to regrade the eroded gully sections between structures. It is intended that these portions of the gully will stabilize by the deposition of transported soil material and through natural succession of plant life.
2. The estimated life of these structures is at least ten years. The service of these structures can be extended and improved by the development and implementation of an operation and maintenance program.
3. Periodically, and particularly following periods of heavy rainfall, inspect the various structures for signs of damage and failure. Repair or replace damaged structures or portions of structures as required.
4. Type 2 structures constructed of posts, welded wire fabric, and brush may require replenishment of the brush material. It is to be expected that such material may be displaced by heavy flow rates and will consolidate with time due to decay and rotting of the native materials.
5. Remove any blockage or obstruction to the weir (spillway) sections of the various structures.
6. Pay particular attention to the areas immediately downstream of the structures. A certain amount of scouring due to water flow can be expected in the immediate downstream areas, but erosion or scouring that may threaten the integrity of the structures will require repair.

SHORELINE STABILIZATION

1. Shoreline stabilization utilizing off-shore breakwaters constructed of stone riprap functions by dissipation of wave energy and the elimination of wave contact with the erosive shoreline soils. No effort is made to regrade or shape the eroded shoreline in the installation process. It is intended that the previously-eroded areas will stabilize through natural processes, including natural succession of plant life, after the construction of the breakwaters.
2. The estimated life of these structures is indefinite with proper monitoring and maintenance.
3. Periodically inspect the installations, paying particular attention to areas of possible damage by wave action or manipulation. Damage may be subtle, and indicated only by a reduction in height of the structure by displacement of the upper surface over time. Such possible reduction in structure height will, however, lead to eventual failure of the section, and must be repaired by the placement of additional stone.
4. Damage may also occur to such structures by deadfall (eroded trees). Such deadfall should be removed, and the displaced stone replaced to original configuration.
5. Damage can also occur due to vandalism or removal of stone for boat access or hunting or fishing access. Such areas will also need to be replaced.

MANAGER'S CERTIFICATION

I, David Fligor, Manager of the Kinkaid-Reed's Creek Conservancy District, do hereby certify that this document is to be considered an official part of the commitment made by the District to the Illinois Environmental Protection Agency in conjunction with the receipt of funding through the Nonpoint Source Pollution Control Program, Section 319(h). These funds, combined with matching funds from other District sources, have been used in the construction of the improvements referenced herein, and the operation and maintenance of these improvements is to be considered an obligation by the District which commences upon the completion of the construction of these improvements.

David Fligor, Manager
Kinkaid-Reed's Creek Conservancy District

Date

ATTACHMENT 4
ESTIMATED LOAD REDUCTION SPREADSHEETS,
SEDIMENTS AND NUTRIENTS

Bank Stabilization

Please fill in the gray areas below. If estimating for just one bank, put "0" in areas for Bank #2.
Once you have successfully estimated the sediment and nutrient load reductions, please print a copy of this worksheet and attach it to the "BMP Application Form" for submittal to the Illinois EPA.

If you have any questions, please contact the Illinois EPA's Nonpoint Source Unit at 217/782-3362.

BMP Number:

3190521-005	Example 319802001
-------------	-----------------------------

Please select a soil textural class:

<input type="checkbox"/> Sands, loamy sands <input type="checkbox"/> Sandy loam <input type="checkbox"/> Fine sandy loam <input type="checkbox"/> Loams, sandy clay loams, sandy clay <input type="checkbox"/> Silt loam	<input type="checkbox"/> Silty clay loam, silty clay <input type="checkbox"/> Clay loam <input type="checkbox"/> Clay <input type="checkbox"/> Organic
--	---

Parameter	Lake Shore Mod.	Lake Shore Sev.	Example
Length (ft)	5529	11227	10000
Height (ft)	4.5	8	6
Lateral Recession Rate (ft/yr)*	0.4	0.5	1
Soil P Conc (lb/lb soil)**	0.0005	0.0005	0.0005
Soil N Conc (lb/lb soil)**	0.001	0.001	0.001

*Lateral Recession Rate (LRR) is the rate at which bank deterioration has taken place and is measured in feet per year. This rate may not be easily determined by direct measurement. Therefore best professional judgement may be required to estimate the LRR. Please refer to the narrative descriptions in Table 1.

** indicates default values for P and N soil concentrations

Table 1

LRR (ft/yr)	Category	Description
0.01 - 0.05	Slight	Some bare bank but active erosion not readily apparent. Some rills but no vegetative overhang. No exposed tree roots.
0.06 - 0.2	Moderate	Bank is predominantly bare with some rills and vegetative overhang.
0.3 - 0.5	Severe	Bank is bare with rills and severe vegetative overhang. Many exposed tree roots and some fallen trees and slumps or slips. Some changes in cultural features such as fence corners missing and realignment of roads or trails. Channel cross-section becomes more U-shaped as opposed to V-shaped.
0.5+	Very Severe	Bank is bare with gullies and severe vegetative overhang. Many fallen trees, drains and culverts eroding out and changes in cultural features as above. Massive slips or washouts common. Channel cross-section is U-shaped and streamcourse or gully may be meandering.

Source: Steffen, L.J. 1982. Channel Erosion (personal communication), as printed in "Pollutants Controlled Calculation and Documentation for Section 319 Watersheds Training Manual," June 1999 Revision; Michigan Department of Environmental Quality - Surface Water Quality Division - Nonpoint Source Unit. EQP 5841 (6/99).

Estimated Load Reductions

	Lake Shore Mod.	Lake Shore Sev.	Example
Sediment Load Reduction (ton/year)	423	1909	2400
Phosphorus Load Reduction (lb/year)	423	1909	2400
Nitrogen Load Reduction (lb/yr)	846	3817	4800

Gully Stabilization

These may include:

- Grade Stabilization Structure
- Grassed Waterway
- Critical Area Planting in areas with gullies
- Water and Sediment Control Basins

Please fill in the gray areas below. Once you have successfully estimated the sediment and nutrient load reductions, please print a copy of this worksheet and attach it to the "BMP Application Form" for submittal to the Illinois EPA.

If you have any questions, please contact the Illinois EPA's Nonpoint Source Unit at 217/782-3362.

BMP Number: **Example**
3199802001

Please select a soil textural class:

<input type="checkbox"/> Sands, loamy sands <input type="checkbox"/> Sandy loam <input type="checkbox"/> Fine sandy loam <input type="checkbox"/> Loams, sandy clay loams, sandy clay <input type="checkbox"/> Silt loam	<input type="checkbox"/> Silty clay loam, silty clay <input type="checkbox"/> Clay loam <input type="checkbox"/> Clay <input type="checkbox"/> Organic
--	---

Parameter		Gully	Example	
Top Width (ft)		18	15	
Bottom Width (ft)		4	4	
Depth (ft)		6	5	
Length (ft)		1100	20	
Number of Years		10	5	
Soil P Conc (lb/lb soil)*	DEFAULT ▼	0.0005	0.0005	*
Soil N Conc (lb/lb soil)*	DEFAULT ▼	0.001	0.001	*

* indicates default values for P and N soil concentrations

Estimated Load Reductions

	Gully	Example
Sediment Load Reduction (ton/year)	309	10
Phosphorus Load Reduction	309	8
Nitrogen Load Reduction (lb/yr)	617	16

Ponds and WASCBs

Please fill in the gray areas only and select which BMP applies.
Additionally a gully stabilization sheet should be completed if applicable.

If you have any questions, please contact the Illinois EPA's Nonpoint Source Unit
at 217/782-3362.

Example

BMP Number:

3190521-001	3199802001
-------------	------------

Please check which BMP applies:

- ☒ Ponds
☐ WASCBs

RUSLE	Area 1	Area 2	Area 3	Area 4	Area 5	Area 6
Rainfall-Runoff Erosivity Factor (R)	220					
Soil Erodibility Factor (K)	0.43					
Length-Slope Factor (LS)	0.35					
Cover Management Factor (C)	0.27					
Support Practice Factor (P)	1					
Avg Annual Soil Loss (ton/acre/year)	8.94	0.00	0.00	0.00	0.00	0.00
Contributing Area (acres)	105					

Total Annual Soil Loss (tons)	939
Total Acres	105
Weighted Annual Soil Loss (ton/ac/yr)	8.94
Sediment Delivery Ratio	52.65%
Sediment Delivery (ton/year)	494
Sediment Trap Efficiency	90%
Sediment Load Reduction (ton/year)	445

Gully Sediment Load Reduction	89
Gully P Load Reduction	89
Gully N Load Reduction	179

Total Sediment Load Reduction	534
Total P Load Reduction	89
Total N Load Reduction	179

Ponds and WASCBs

Please fill in the gray areas only and select which BMP applies.
Additionally a gully stabilization sheet should be completed if applicable.

If you have any questions, please contact the Illinois EPA's Nonpoint Source Unit
at 217/782-3362.

Example

BMP Number: 3190521-002 3199802001

Please check which BMP applies:

- ☒ Ponds
☐ WASCBs

RUSLE	Area 1	Area 2	Area 3	Area 4	Area 5	Area 6
Rainfall-Runoff Erosivity Factor (R)	220					
Soil Erodibility Factor (K)	0.43					
Length-Slope Factor (LS)	0.35					
Cover Management Factor (C)	0.27					
Support Practice Factor (P)	1					
Avg Annual Soil Loss (ton/acre/year)	8.94	0.00	0.00	0.00	0.00	0.00
Contributing Area (acres)	13					

Total Annual Soil Loss (tons)	116
Total Acres	13
Weighted Annual Soil Loss (ton/ac/yr)	8.94
Sediment Delivery Ratio	68.36%
Sediment Delivery (ton/year)	79
Sediment Trap Efficiency	90%
Sediment Load Reduction (ton/year)	71

Gully Sediment Load Reduction	2
Gully P Load Reduction	2
Gully N Load Reduction	4

Total Sediment Load Reduction	74
Total P Load Reduction	2
Total N Load Reduction	4

Ponds and WASCBs

Please fill in the gray areas only and select which BMP applies.
Additionally a gully stabilization sheet should be completed if applicable.

If you have any questions, please contact the Illinois EPA's Nonpoint Source Unit
at 217/782-3362.

Example

BMP Number: 3190521-003 3199802001

Please check which BMP applies:

- ☒ Ponds
☐ WASCBs

RUSLE	Area 1	Area 2	Area 3	Area 4	Area 5	Area 6
Rainfall-Runoff Erosivity Factor (R)	220					
Soil Erodibility Factor (K)	0.43					
Length-Slope Factor (LS)	0.35					
Cover Management Factor (C)	0.27					
Support Practice Factor (P)	1					
Avg Annual Soil Loss (ton/acre/year)	8.94	0.00	0.00	0.00	0.00	0.00
Contributing Area (acres)	22					

Total Annual Soil Loss (tons)	197
Total Acres	22
Weighted Annual Soil Loss (ton/ac/yr)	8.94
Sediment Delivery Ratio	64.01%
Sediment Delivery (ton/year)	126
Sediment Trap Efficiency	90%
Sediment Load Reduction (ton/year)	113

Gully Sediment Load Reduction	4
Gully P Load Reduction	4
Gully N Load Reduction	9

Total Sediment Load Reduction	118
Total P Load Reduction	4
Total N Load Reduction	9

ATTACHMENT 5
PROJECT PICTURES



ENDLOADER LOADING RR 4 RIPRAP ON MECHANICAL BOAT



CREW PLACING FILTER FABRIC IN ADVANCE OF RIPRAP PLACEMENT



RIPRAP PLACEMENT ON INSTALLED FILTER FABRIC



RIPRAP PLACEMENT USING MECHANICAL BOAT



SAME PROCESS, DIFFERENT PERSPECTIVE



FINISHED PRODUCT: OFFSHORE BREAKWATER USING RR 4 RIPRAP



EXAMPLE OF FINISHED WORK



SEDIMENT / NUTRIENT DETENTION BASIN #1: STRAW MULCH APPLICATION



**SEDIMENT / NUTRIENT DETENTION BASIN #1: BASIN AND UPSTREAM
FACE OF DAM PRIOR TO FILLING**



**SEDIMENT / NUTRIENT DETENTION BASIN #2: UPSTREAM SLOPE OF
DAM**



SEDIMENT / NUTRIENT DETENTION BASIN #2: PRIOR TO FILLING



SEDIMENT / NUTRIENT DETENTION BASIN #2: DOWNSTREAM SLOPE OF DAM



GULLY STABILIZATION – STRUCTURE TYPE 1



GULLY STABILIZATION – STRUCTURE TYPE 2



GULLY STABILIZATION – STRUCTURE TYPE 3




GULLY STABILIZATION – STRUCTURE TYPE 4

ATTACHMENT 6
AS-BUILT DRAWINGS


JACKSON COUNTY, ILLINOIS

C-1	COVER SHEET
C-2	SITE PLAN
C-3	PLAN-PROFILE, TYPICAL SECTION

1. ALL WORK TO BE IN ACCORDANCE WITH USDA, NRCS STANDARDS.
2. COORDINATES INDICATED ARE TO BE CONSIDERED A LOCAL COORDINATE SYSTEM. ELEVATIONS INDICATED ARE BASED ON 1983 N.A. VERTICAL DATUM.

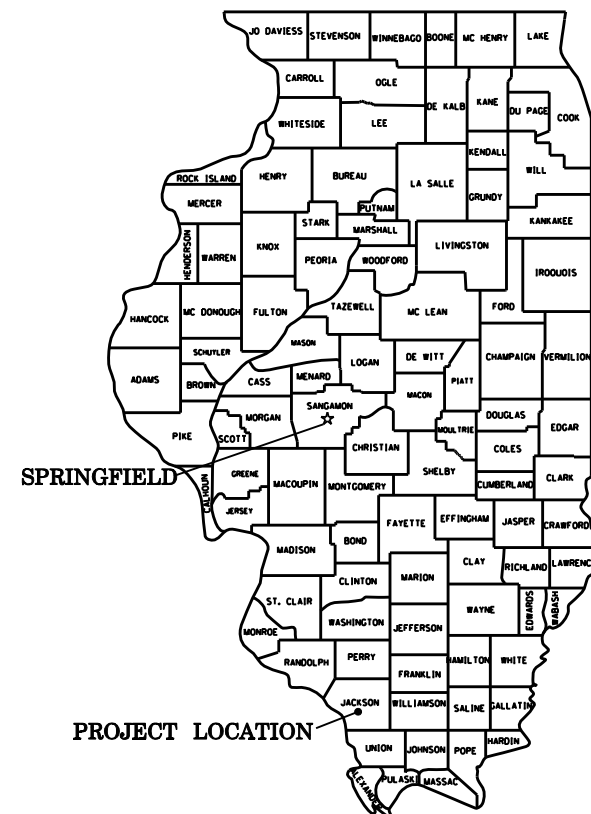



STATE LOCATION MAP
NOT TO SCALE

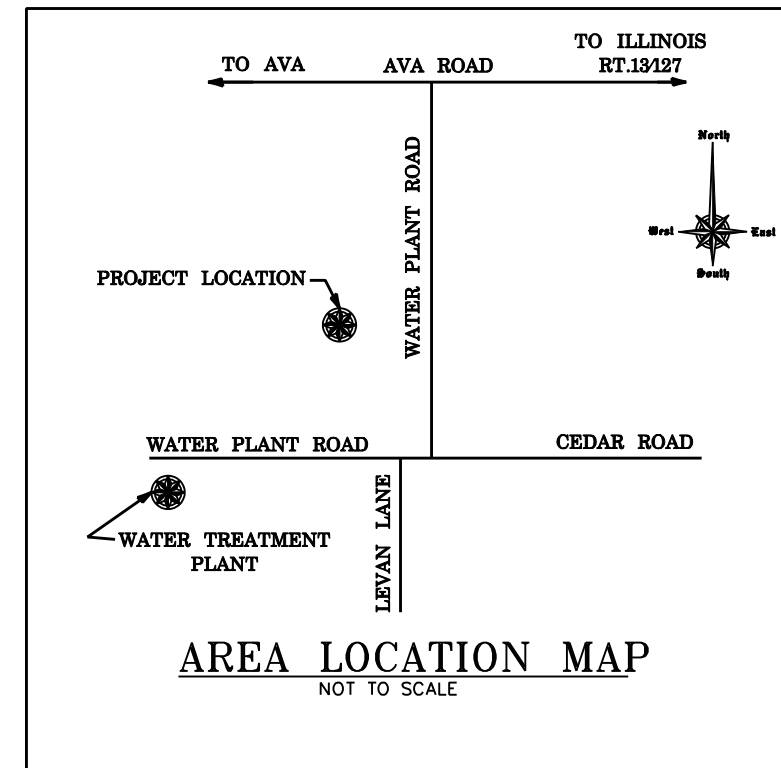


AREA LOCATION MAP


NOT TO SCALE

[illegible]

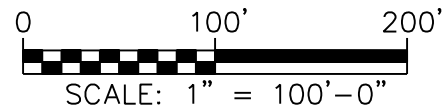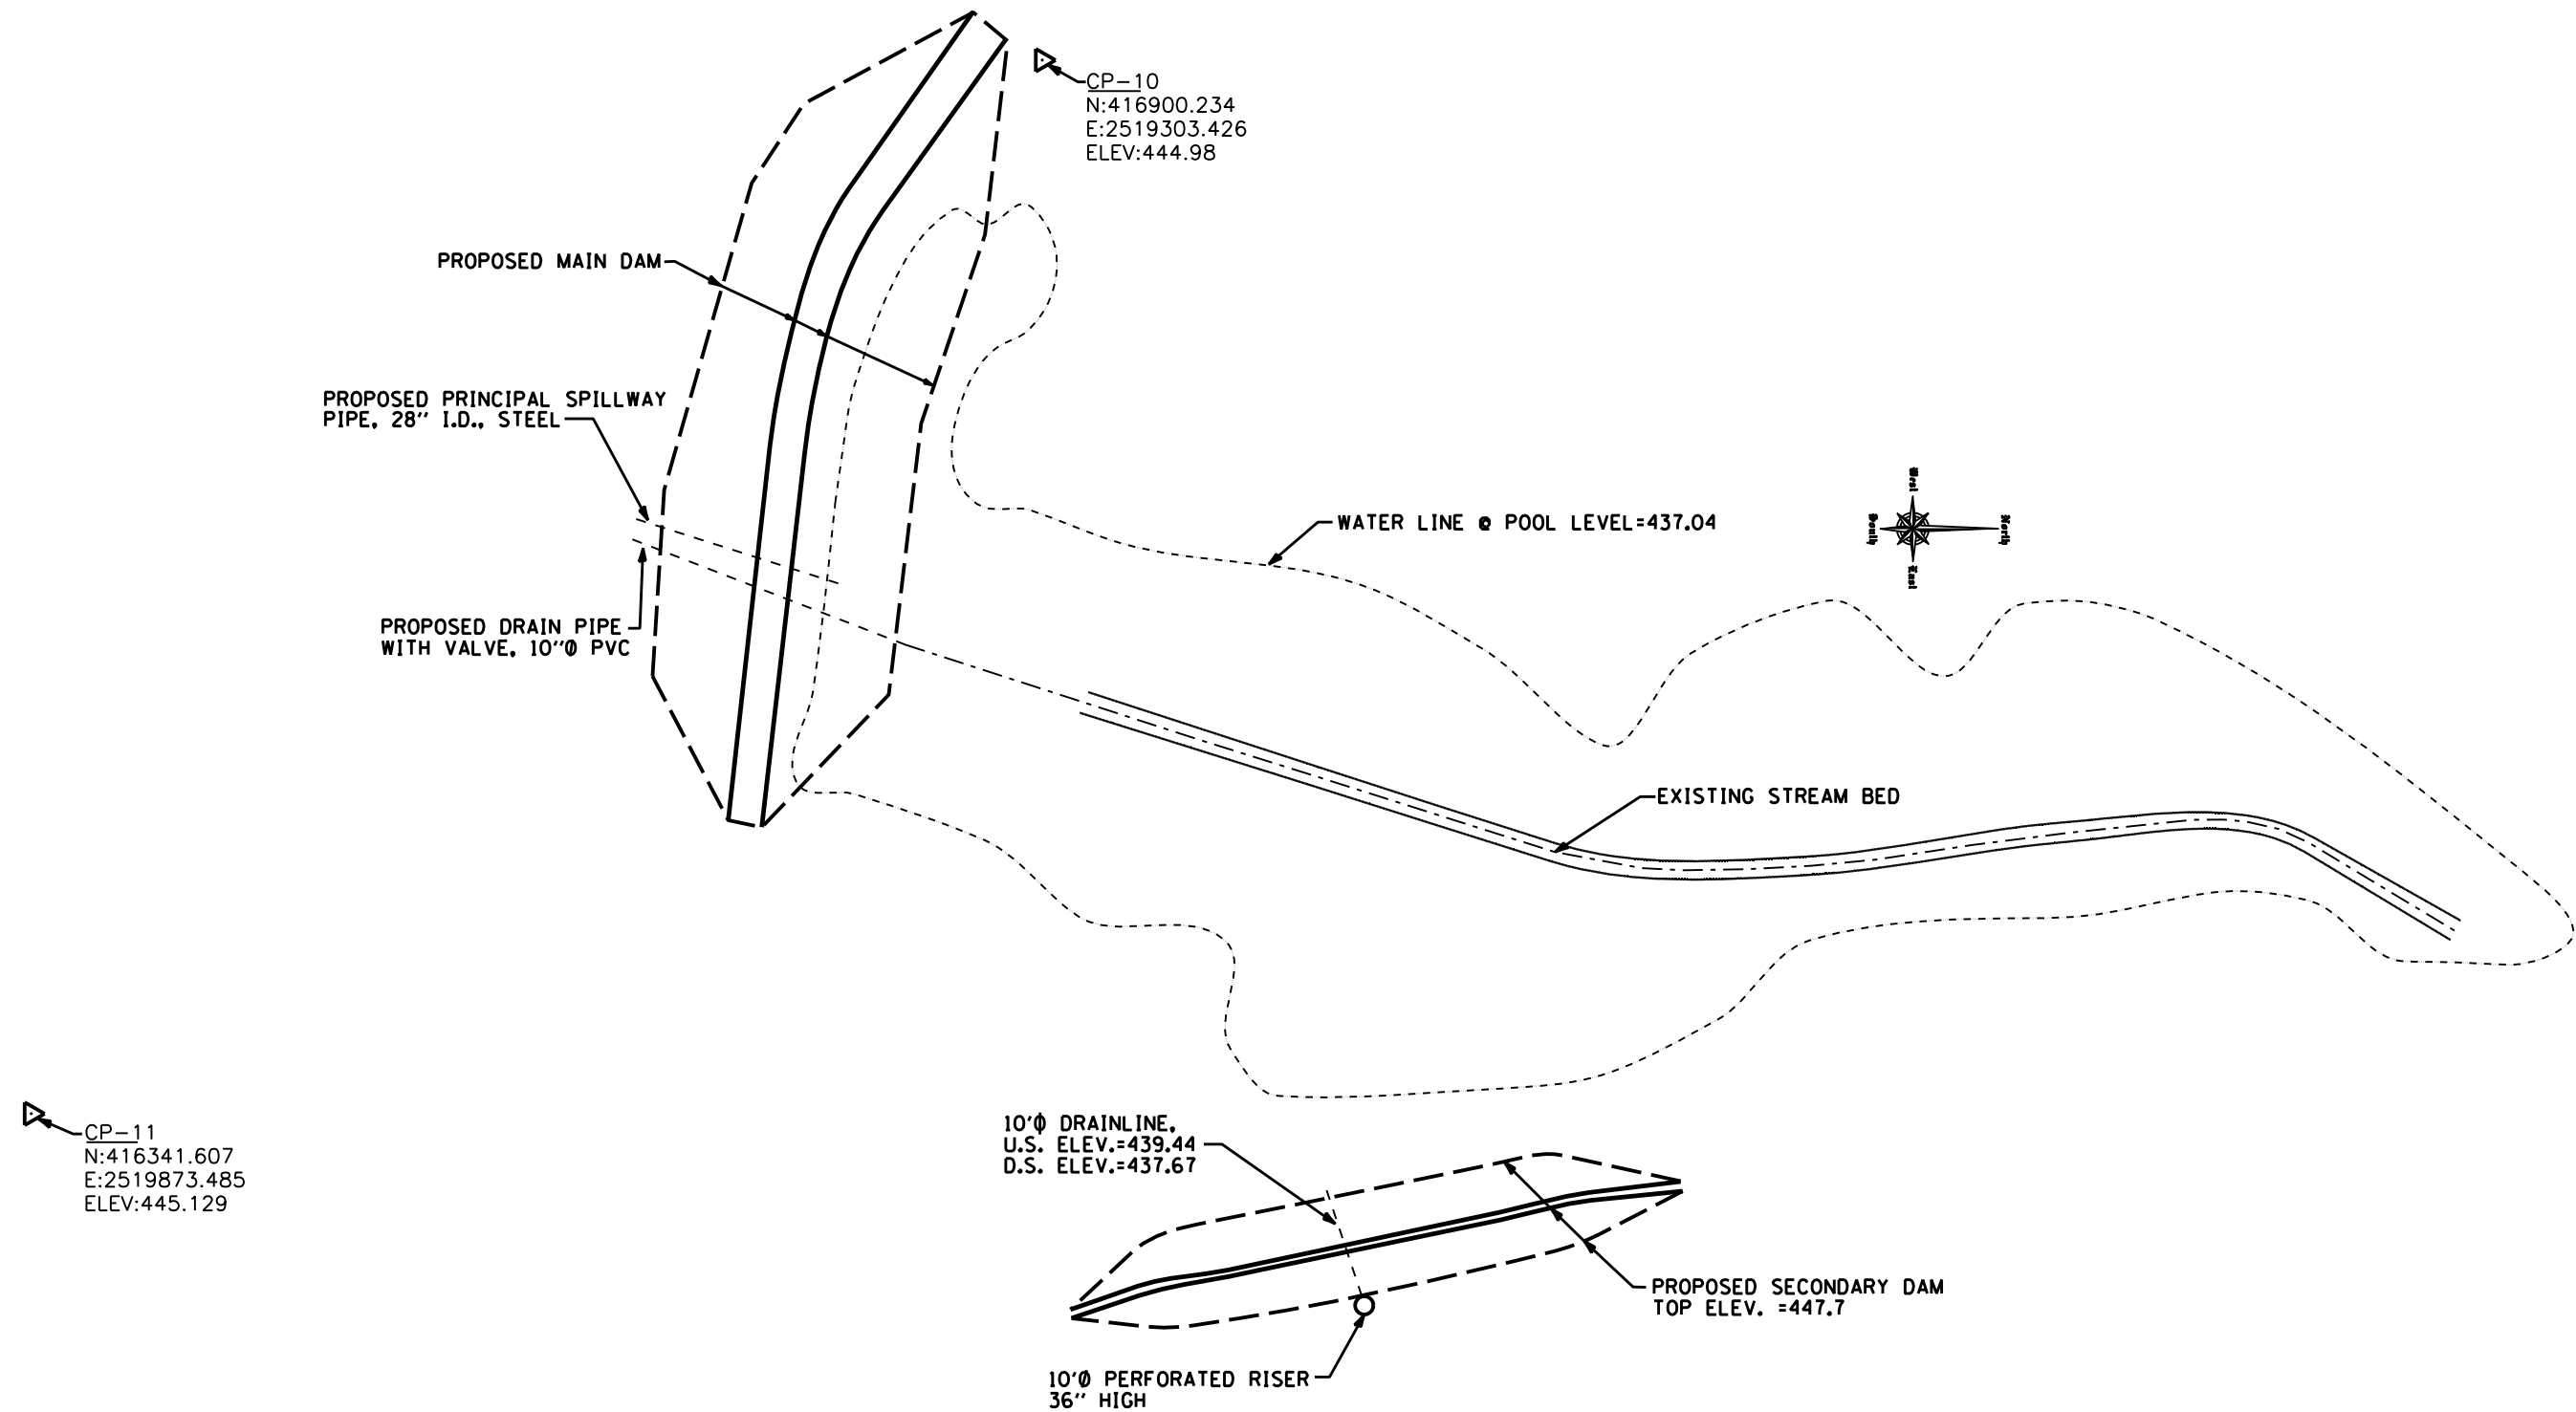


		 <div>Cochran & Wilken, Inc. Consulting Engineers & Scientists</div> <div>5201 South Sixth Street Road, Springfield, IL 62703-5143 1339 Walnut St. Murphysboro, IL 62966 Ph. (217) 585-8300 Ph. (618) 684-5808</div>			Approved:	Drawing Title SITE PLAN POND #1 CONSTRUCTION	Project Title PROPOSED POND CONSTRUCTION- AS BUILTS			
					DAVID FLIGOR, MANAGER KINKAID-REED'S CREEK COVSERVANCY DISTRICT		Location JACKSON COUNTY, ILLINOIS	Project No.	DRAWING NO. C2	
							Date JANUARY 04, 2007	Checked JAZ	Building Number	Dwg. 2 of 3
Revisions	Date									

KEY NOTES :

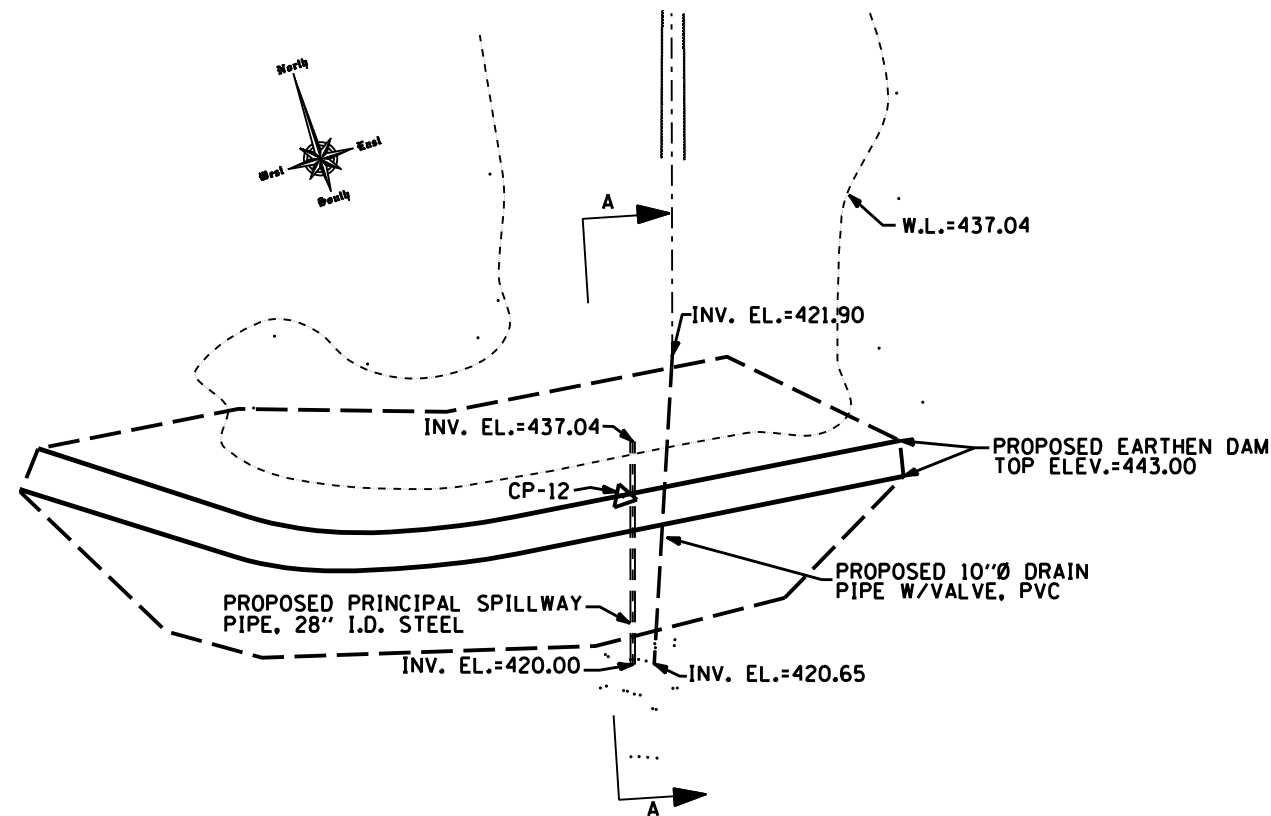


NOTE: DAM CONFIGURATION TYPICAL FOR ENTIRE LENGTH

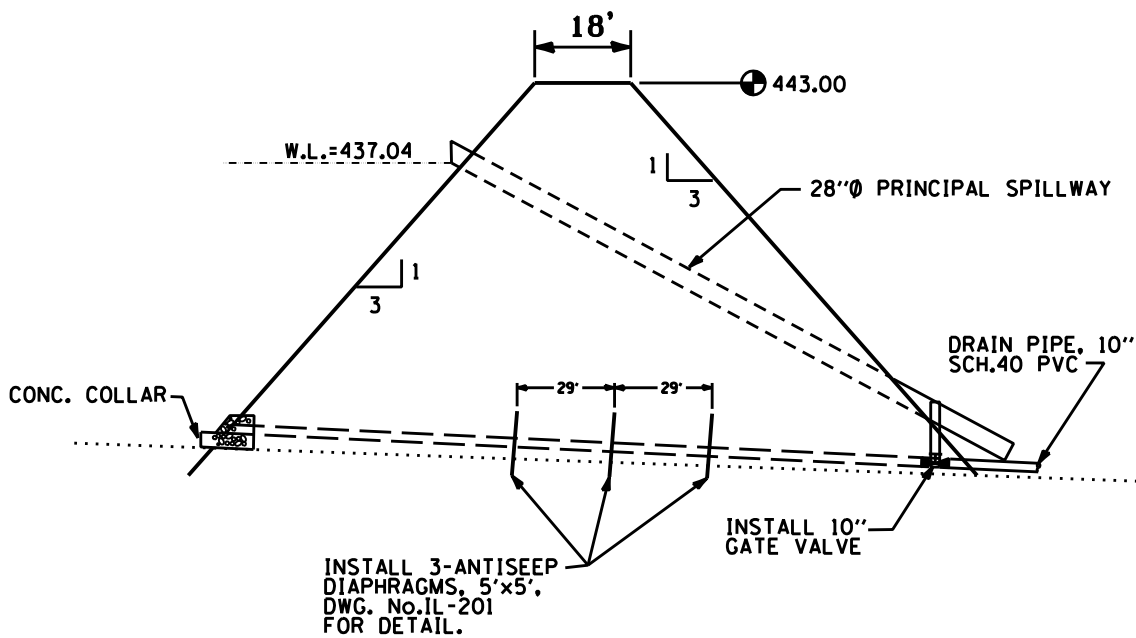


SECTION A-A
N.T.S.

LEGEND

- DAM SLOPE TOE
- TOP OF DAM
- WATER SURFACE

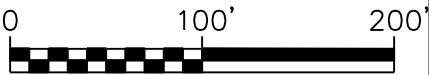

SCALE: 1" = 100'-0"

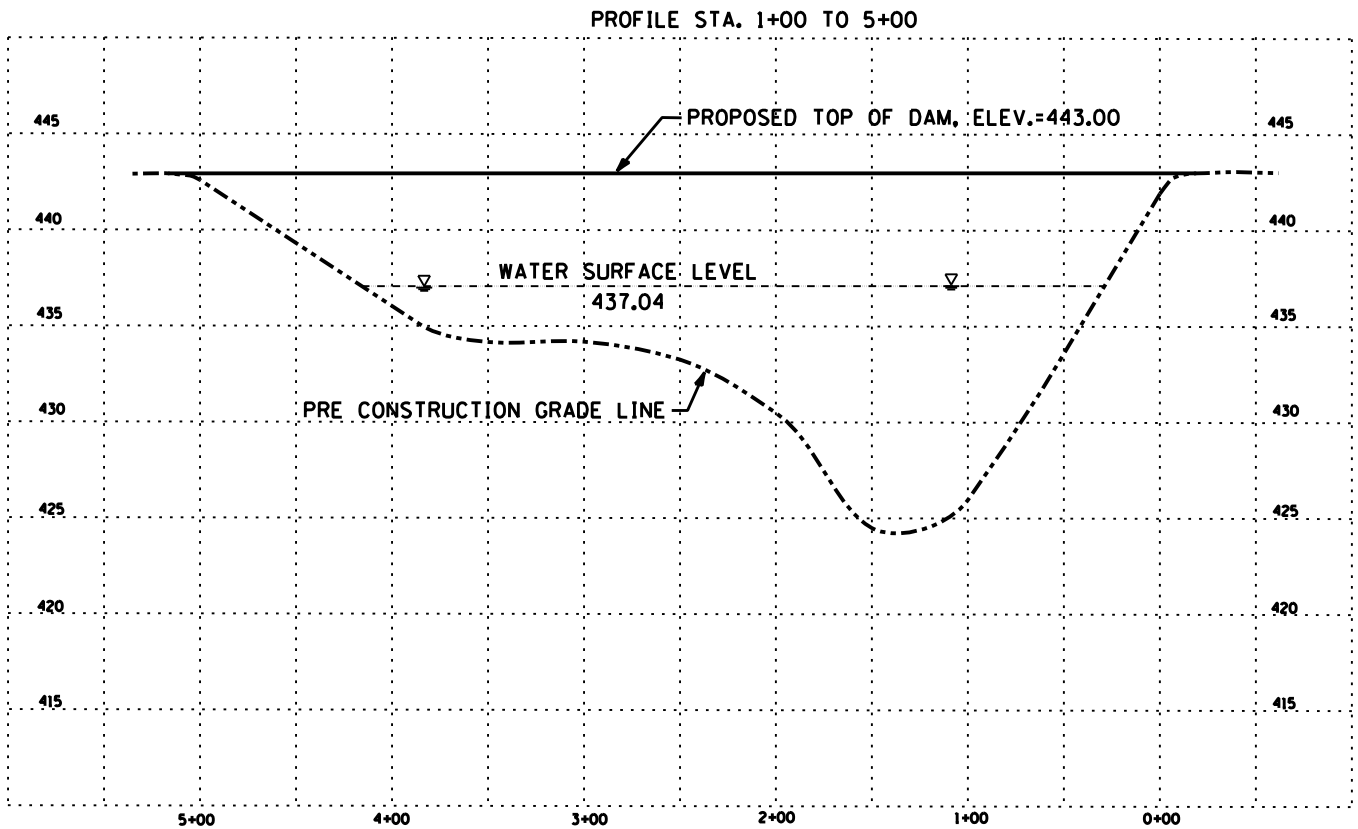

Revisions	Date

Cochran & Wilken, Inc.
Consulting Engineers & Scientists
5201 South Sixth Street Road, Springfield, IL 62703-5143
1339 Walnut St. Murphysboro, IL 62966
Ph. (217) 585-8300
Ph. (618) 684-5808

Approved:



DAVID FLIGOR, MANAGER
KINKAID-REED'S CREEK COVSERVANCY DISTRICT

Drawing Title PLAN-PROFILE/ TYPICAL CROSS SECTION	Project Title PROPOSED POND CONSTRUCTION- AS BUILTS	Project No.	DRAWING NO. C3
Location JACKSON COUNTY, ILLINOIS	Date JANUARY 04, 2007	Building Number -	Dwg. 3 of 3
Checked JAZ	Drawn JAZ		

PLANS FOR CONSTRUCTION OF
SEDIMENT / NUTRIENT DETENTION BASINS,
GULLY STABILIZATION and LAKE SHORELINE STABILIZATION
FOR KINKAID-REED'S CREEK CONSERVANCY DISTRICT
JACKSON COUNTY, ILLINOIS

INDEX OF SHEETS


C1	COVER SHEET
C2	PROJECT LOCATION MAP
C3	SEDIMENT / NUTRIENT DETENTION SITE PLAN
C4	SEDIMENT / NUTRIENT DETENTION BASIN No.2 DETAILS
C5	SEDIMENT / NUTRIENT DETENTION BASIN No.3 DETAILS
C6	GULLY No.1 STABILIZATION PROFILE AND STRUCTURE LOCATIONS
C7-C8	GULLY No.1 STABILIZATION CROSS SECTIONS
C9	GULLY No.2 STABILIZATION PROFILE AND STRUCTURE LOCATIONS
C10-C11	GULLY No.2 STABILIZATION CROSS SECTIONS
C12	GULLY STABILIZATION STRUCTURE DETAILS
C13	SHORELINE STABILIZATION LOCATION MAP
C14	SHORELINE STABILIZATION STUCTURE AND ANTISEEP COLLAR DETAILS

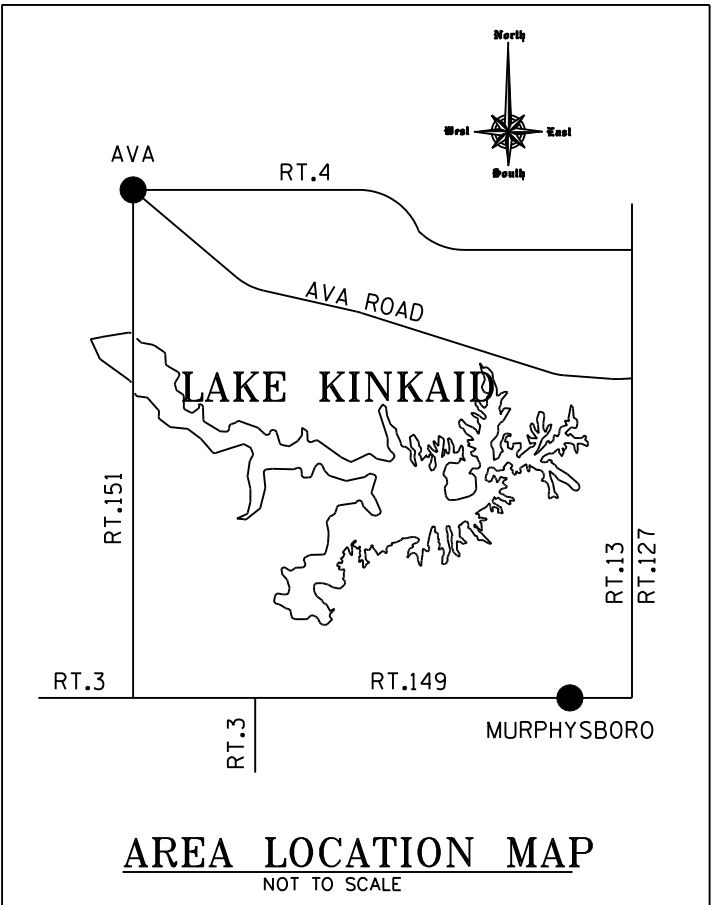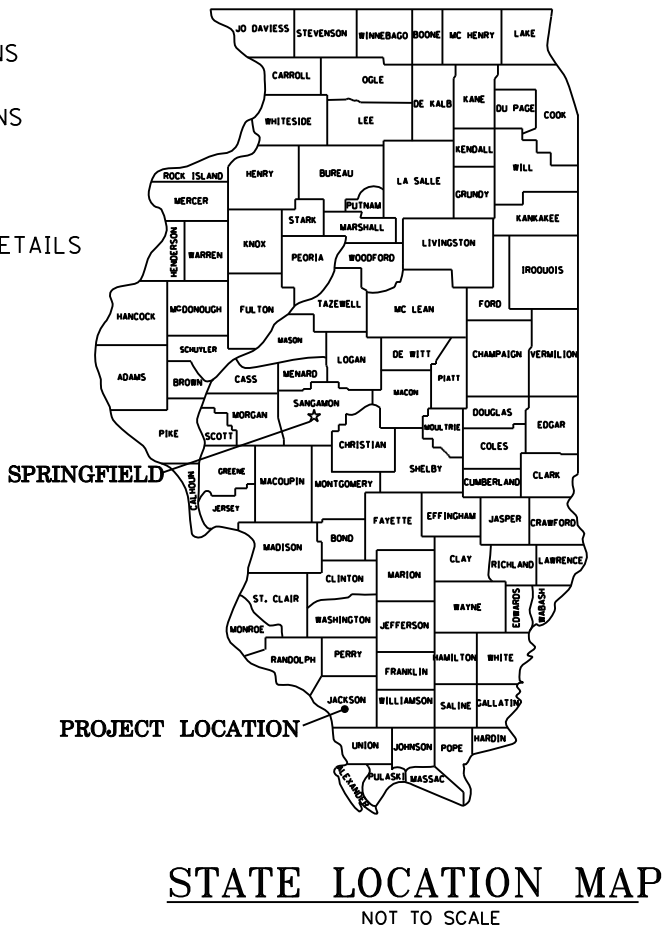

NOTE:
SEE SHEET C2 FOR DETAILED PROJECT LOCATION MAP

KEY NOTES :



1. ALL WORK TO BE IN ACCORDANCE WITH USDA, NRCS STANDARDS.
2. COORDINATES INDICATED ARE TO BE CONSIDERED A LOCAL COORDINATE SYSTEM. ELEVATIONS INDICATED ARE BASED ON 1983 N.A. VERTICAL DATUM.
3. SEE SHEET 2 FOR PROJECT LOCATION MAP.
4. ALL CONSTRUCTION IS TO BE IN ACCORDANCE WITH THE USDA, NRCS NATIONAL ENGINEERING HANDBOOK (NEH), PART 642, CHAPTERS 2 & 3, CONSTRUCTION & MATERIAL SPECIFICATIONS.
5. CROSS SECTIONS NOT INCLUDED IN "AS BUILT" SET.

		 Cochran & Wilken, Inc. Consulting Engineers & Scientists 5201 South Sixth Street Road, Springfield, IL 62703-5143 1339 Walnut St. Murphysboro, IL 62966 Ph. (217) 585-8300 Ph. (618) 684-5808			Approved:	Drawing Title	Project Title		Project No.		DRAWING NO. C1					
						COVER SHEET	SEDIMENT/NUTRIENT DETENTION BASINS, GULLY STABILIZATION, LAKE SHORELINE STABILIZATION									
						AS BUILT	Location JACKSON COUNTY, ILLINOIS									
								Date JANUARY 04, 2007		Checked			Drawn JAZ	Building Number	Dwg. 1 of 14	
Revisions	Date					DAVID FLIGOR, MANAGER KINKAID-REED'S CREEK COVSERVANCY DISTRICT									

PLANS FOR CONSTRUCTION OF
SEDIMENT / NUTRIENT DETENTION BASINS,
GULLY STABILIZATION and LAKE SHORELINE STABILIZATION
FOR KINKAID-REED'S CREEK CONSERVANCY DISTRICT
JACKSON COUNTY, ILLINOIS

INDEX OF SHEETS


C1	COVER SHEET
C2	PROJECT LOCATION MAP
C3	SEDIMENT / NUTRIENT DETENTION SITE PLAN
C4	SEDIMENT / NUTRIENT DETENTION BASIN No.2 DETAILS
C5	SEDIMENT / NUTRIENT DETENTION BASIN No.3 DETAILS
C6	GULLY No.1 STABILIZATION PROFILE AND STRUCTURE LOCATIONS
C7-C8	GULLY No.1 STABILIZATION CROSS SECTIONS
C9	GULLY No.2 STABILIZATION PROFILE AND STRUCTURE LOCATIONS
C10-C11	GULLY No.2 STABILIZATION CROSS SECTIONS
C12	GULLY STABILIZATION STRUCTURE DETAILS
C13	SHORELINE STABILIZATION LOCATION MAP
C14	SHORELINE STABILIZATION STUCTURE AND ANTISEEP COLLAR DETAILS

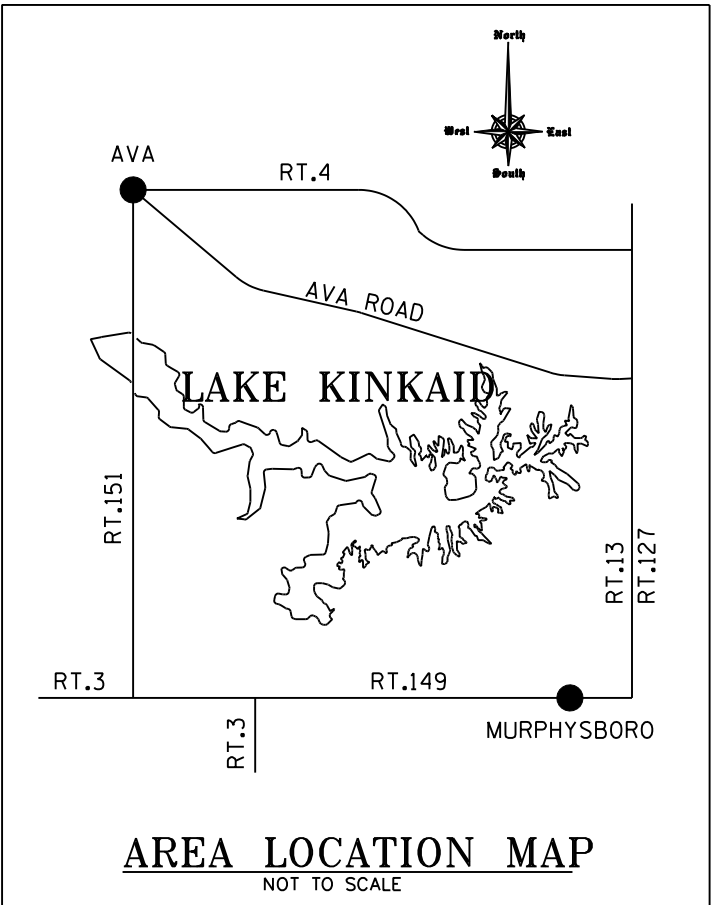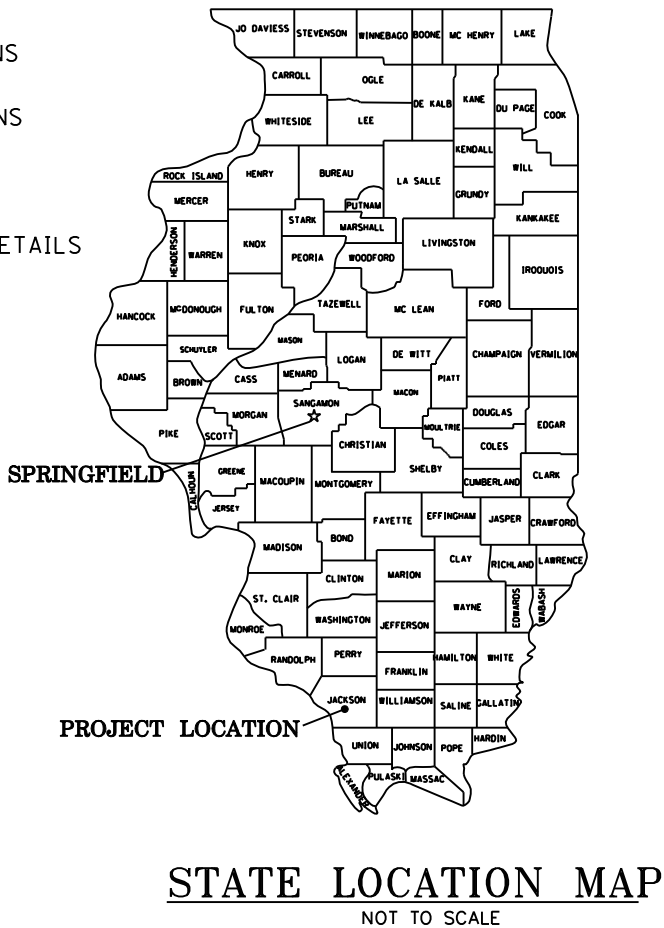


NOTE:
SEE SHEET C2 FOR DETAILED PROJECT LOCATION MAP


KEY NOTES :

1. ALL WORK TO BE IN ACCORDANCE WITH USDA, NRCS STANDARDS.
2. COORDINATES INDICATED ARE TO BE CONSIDERED A LOCAL COORDINATE SYSTEM. ELEVATIONS INDICATED ARE BASED ON 1983 N.A. VERTICAL DATUM.
3. SEE SHEET 2 FOR PROJECT LOCATION MAP.
4. ALL CONSTRUCTION IS TO BE IN ACCORDANCE WITH THE USDA, NRCS NATIONAL ENGINEERING HANDBOOK (NEH), PART 642, CHAPTERS 2 & 3, CONSTRUCTION & MATERIAL SPECIFICATIONS.
5. CROSS SECTIONS NOT INCLUDED IN "AS BUILT" SET.

		 <div>Cochran & Wilken, Inc. Consulting Engineers & Scientists</div> <div>5201 South Sixth Street Road, Springfield, IL 62703-5143 1339 Walnut St. Murphysboro, IL 62966 Ph. (217) 585-8300 Ph. (618) 684-5808</div>			Approved:	Drawing Title	Project Title			
						COVER SHEET	SEDIMENT/NUTRIENT DETENTION BASINS, GULLY STABILIZATION, LAKE SHORELINE STABILIZATION			
						AS BUILT	Location	JACKSON COUNTY, ILLINOIS	Project No.	DRAWING NO.
						DAVID FLIGOR, MANAGER KINKAID-REED'S CREEK COVSERVANCY DISTRICT	Date	JANUARY 04, 2007	Checked	Drawn
								JAZ	Building Number	C1 Dwg. 1 of 14
Revisions	Date									

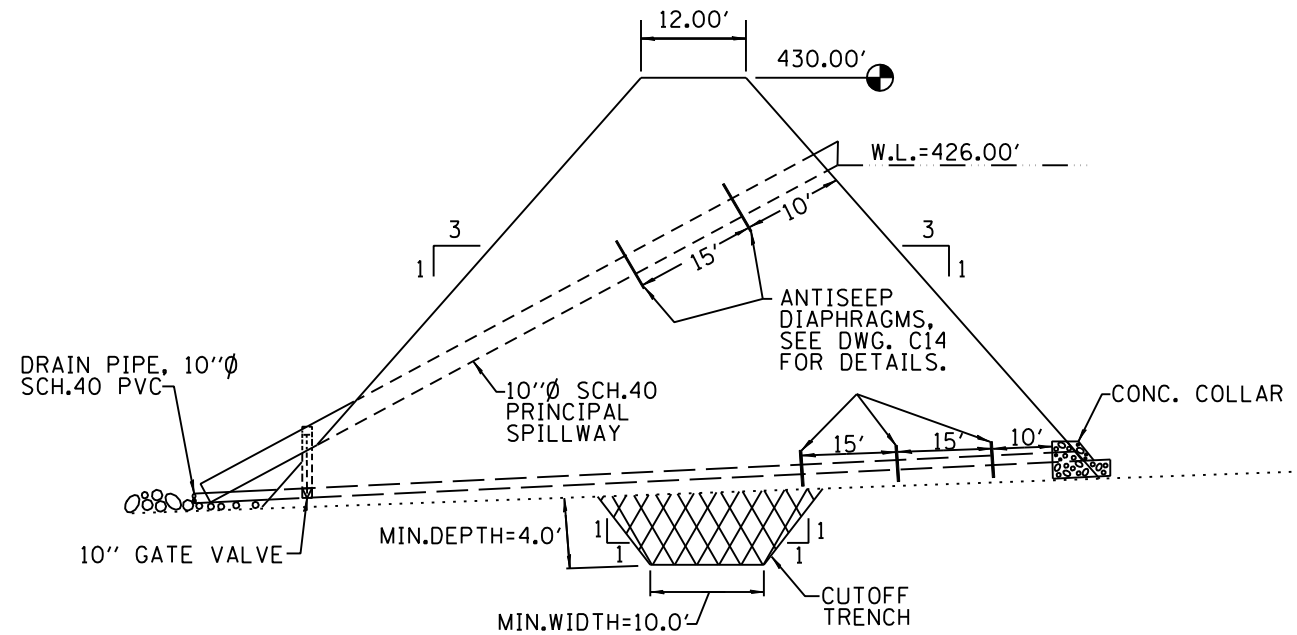


NOTE:
 1. DAM CONFIGURATION TYPICAL FOR ENTIRE LENGTH
SECTION A-A
 N.T.S.

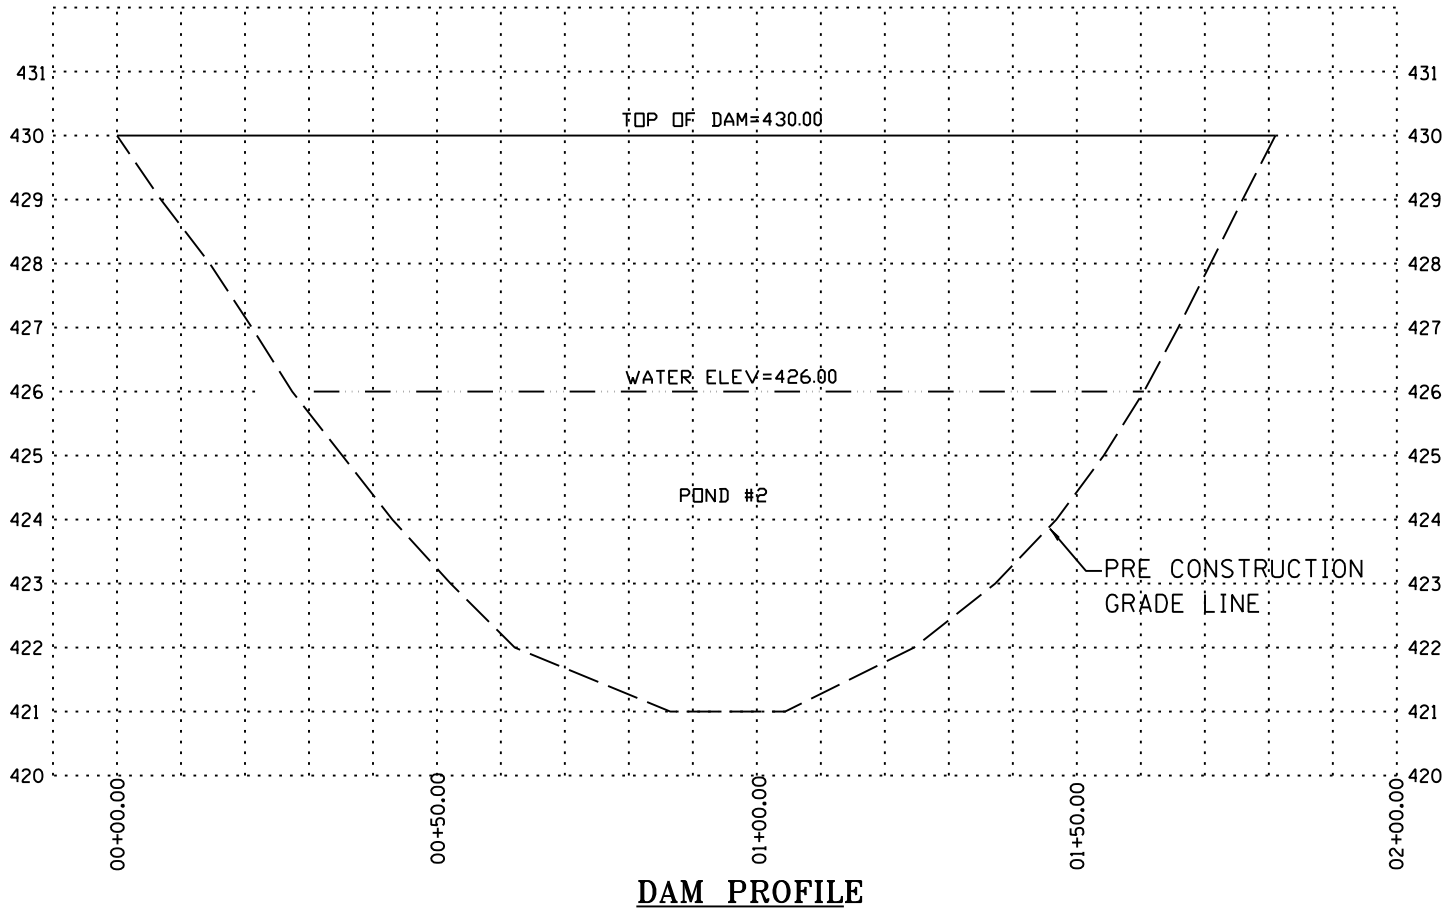


DAM PROFILE

REFERENCE POINT
 N:417,989.723
 E:2,518,115.075
 ELEV:430.00

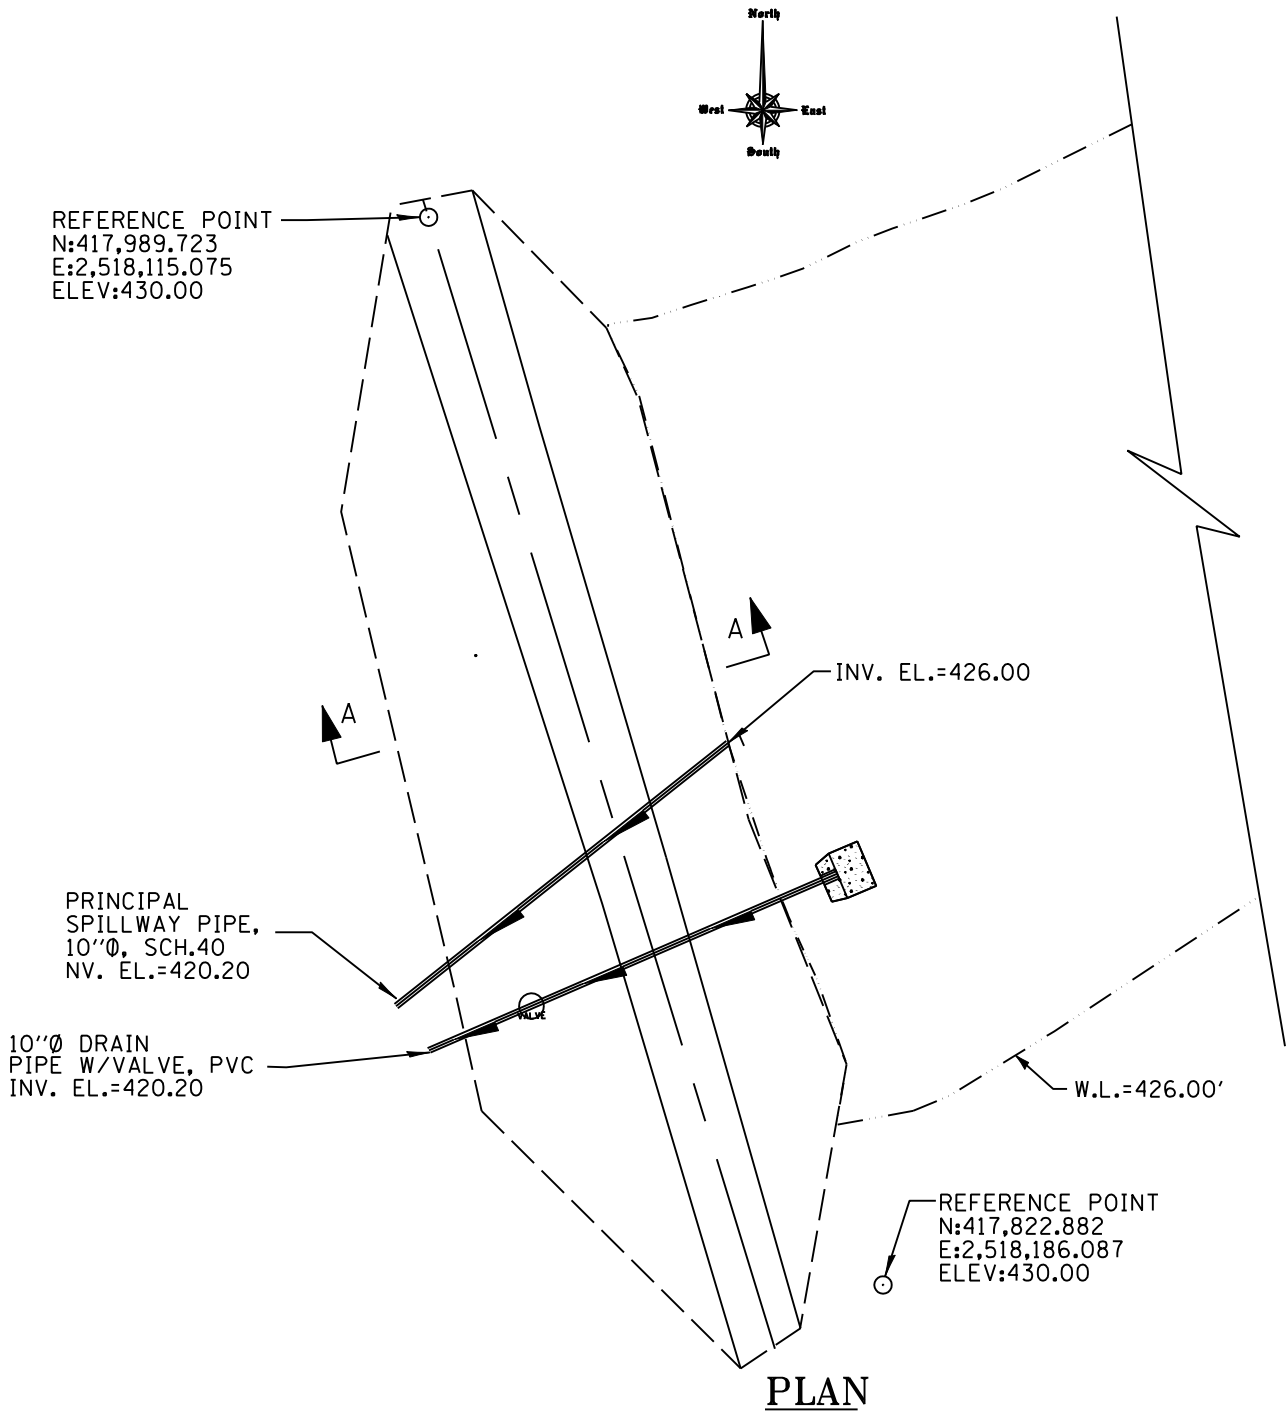

PLAN




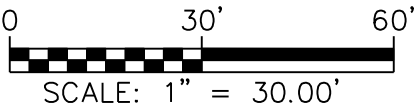


LEGEND	
	DAM SLOPE TOE
	TOP OF DAM
	CENTERLINE TOP OF DAM
	WATER SURFACE


Revisions Date	 Cochran & Wilken, Inc. Consulting Engineers & Scientists 5201 South Sixth Street Road, Springfield, IL 62703-5143 1339 Walnut St. Murphysboro, IL 62966 Ph. (217) 585-8300 Ph. (618) 684-5808	Approved:	Drawing Title PLAN-PROFILE/ TYPICAL CROSS SECTION	Project Title SEDIMENT/NUTRIENT DETENTION BASINS, GULLY STABILIZATION, LAKE SHORELINE STABILIZATION	POND #2
			AS BUILT	Location JACKSON COUNTY, ILLINOIS	Project No.
			Date JANUARY 04, 2007	Checked JAZ	Building Number
			Dwg. 4 of 14	C4	Drawing NO.


NOTES:

1. DAM CONFIGURATION TYPICAL FOR ENTIRE LENGTH

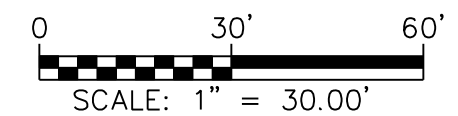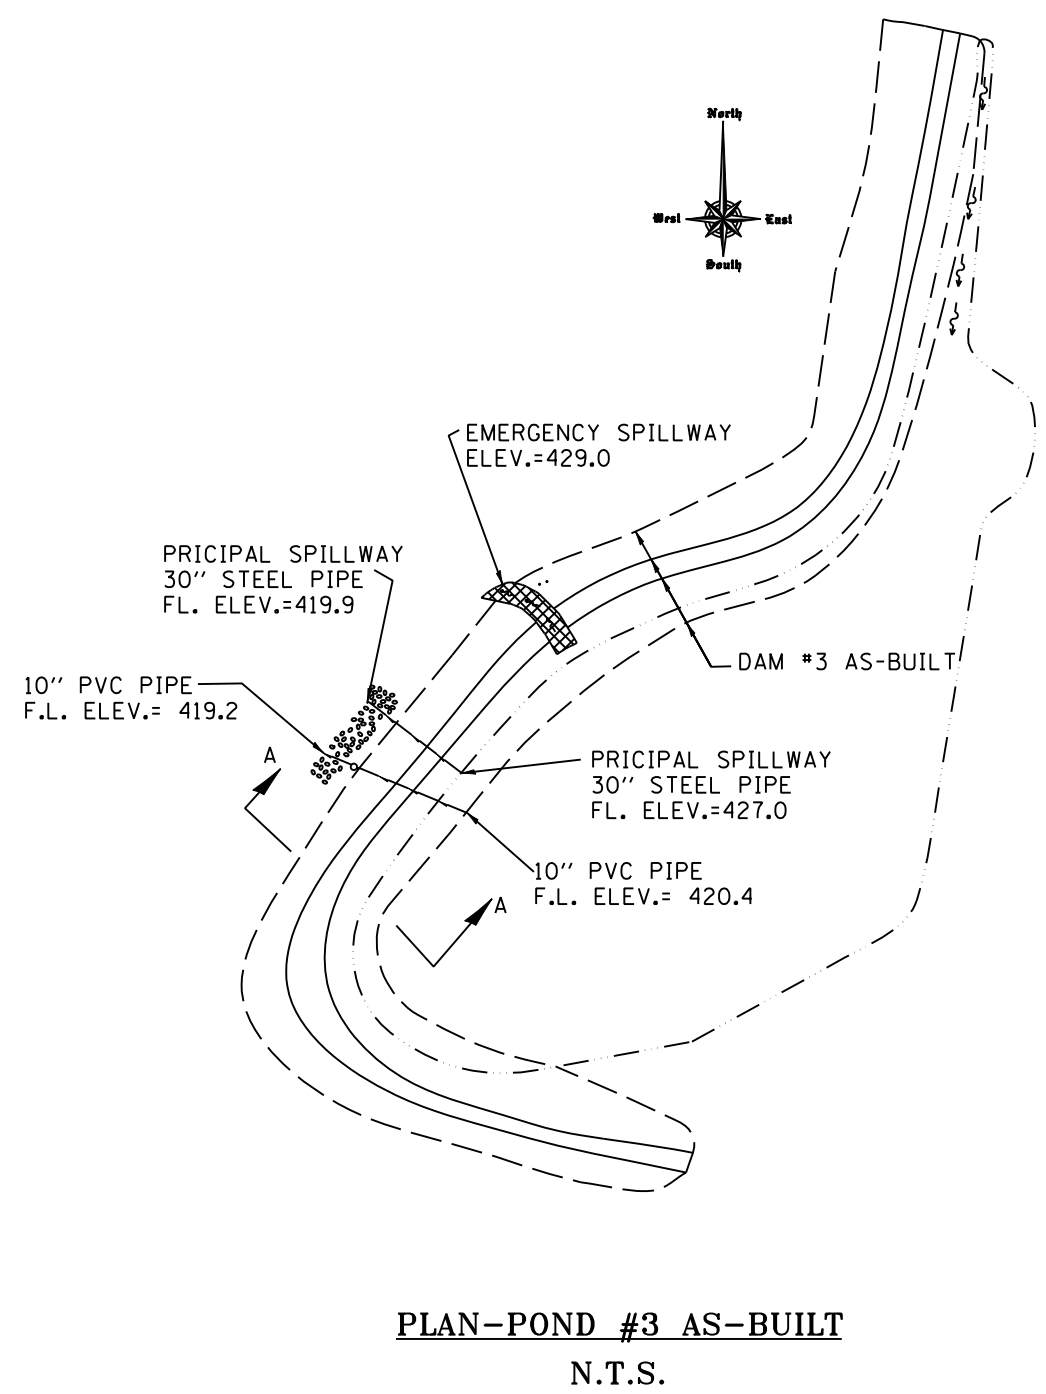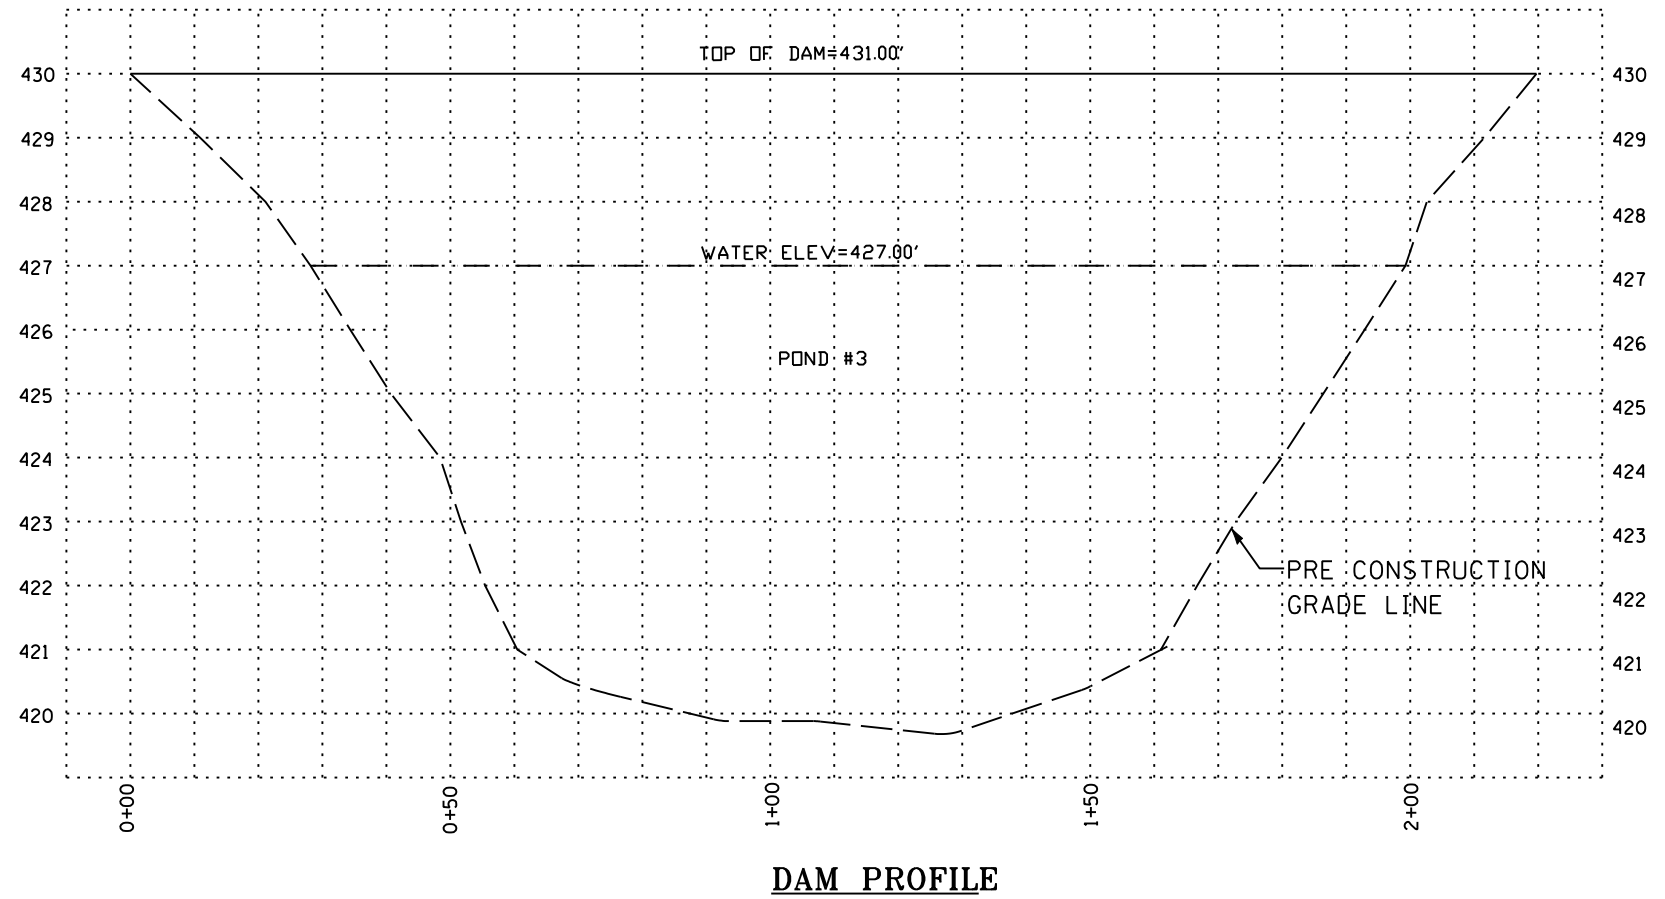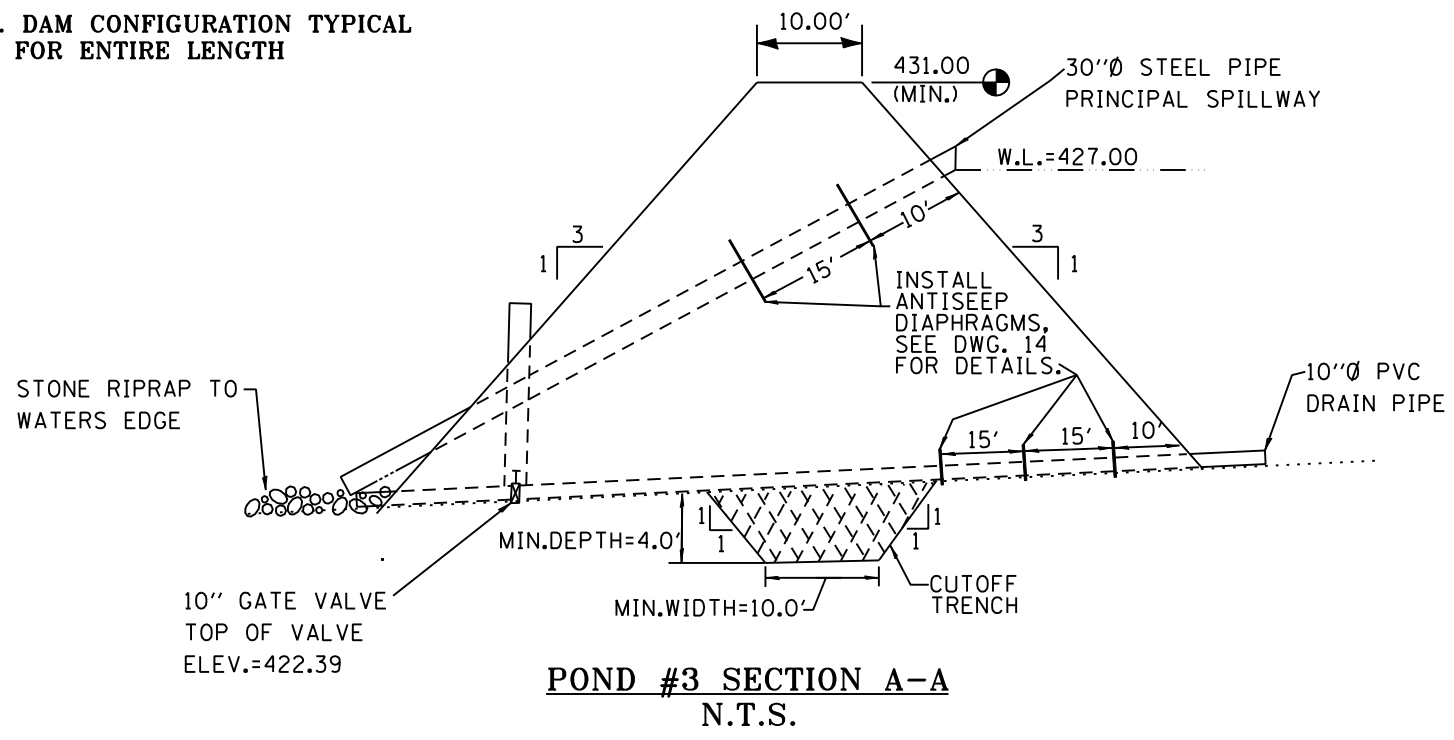


LEGEND	
---	DAM SLOPE TOE
---	TOP OF DAM
---	WATER SURFACE

		 Cochran & Wilken, Inc. Consulting Engineers & Scientists 5201 South Sixth Street Road, Springfield, IL 62703-5143 1339 Walnut St. Murphysboro, IL 62966 Ph. (217) 585-8300 Ph. (618) 684-5808	Approved:	Project Title PLAN-PROFILE/ TYPICAL CROSS SECTION	Drawing Title PLAN-PROFILE/ TYPICAL CROSS SECTION		Project Title SEDIMENT/NUTRIENT DETENTION BASINS, GULLY STABILIZATION, LAKE SHORELINE STABILIZATION		POND #3 AS-BUILT			
							Location JACKSON COUNTY, ILLINOIS		Project No.		DRAWING NO. C5	
							Date AUGUST 07, 2007	Checked JAZ	Drawn JAZ	Building Number ...		Dwg. 5 of 14
Revisions	Date											

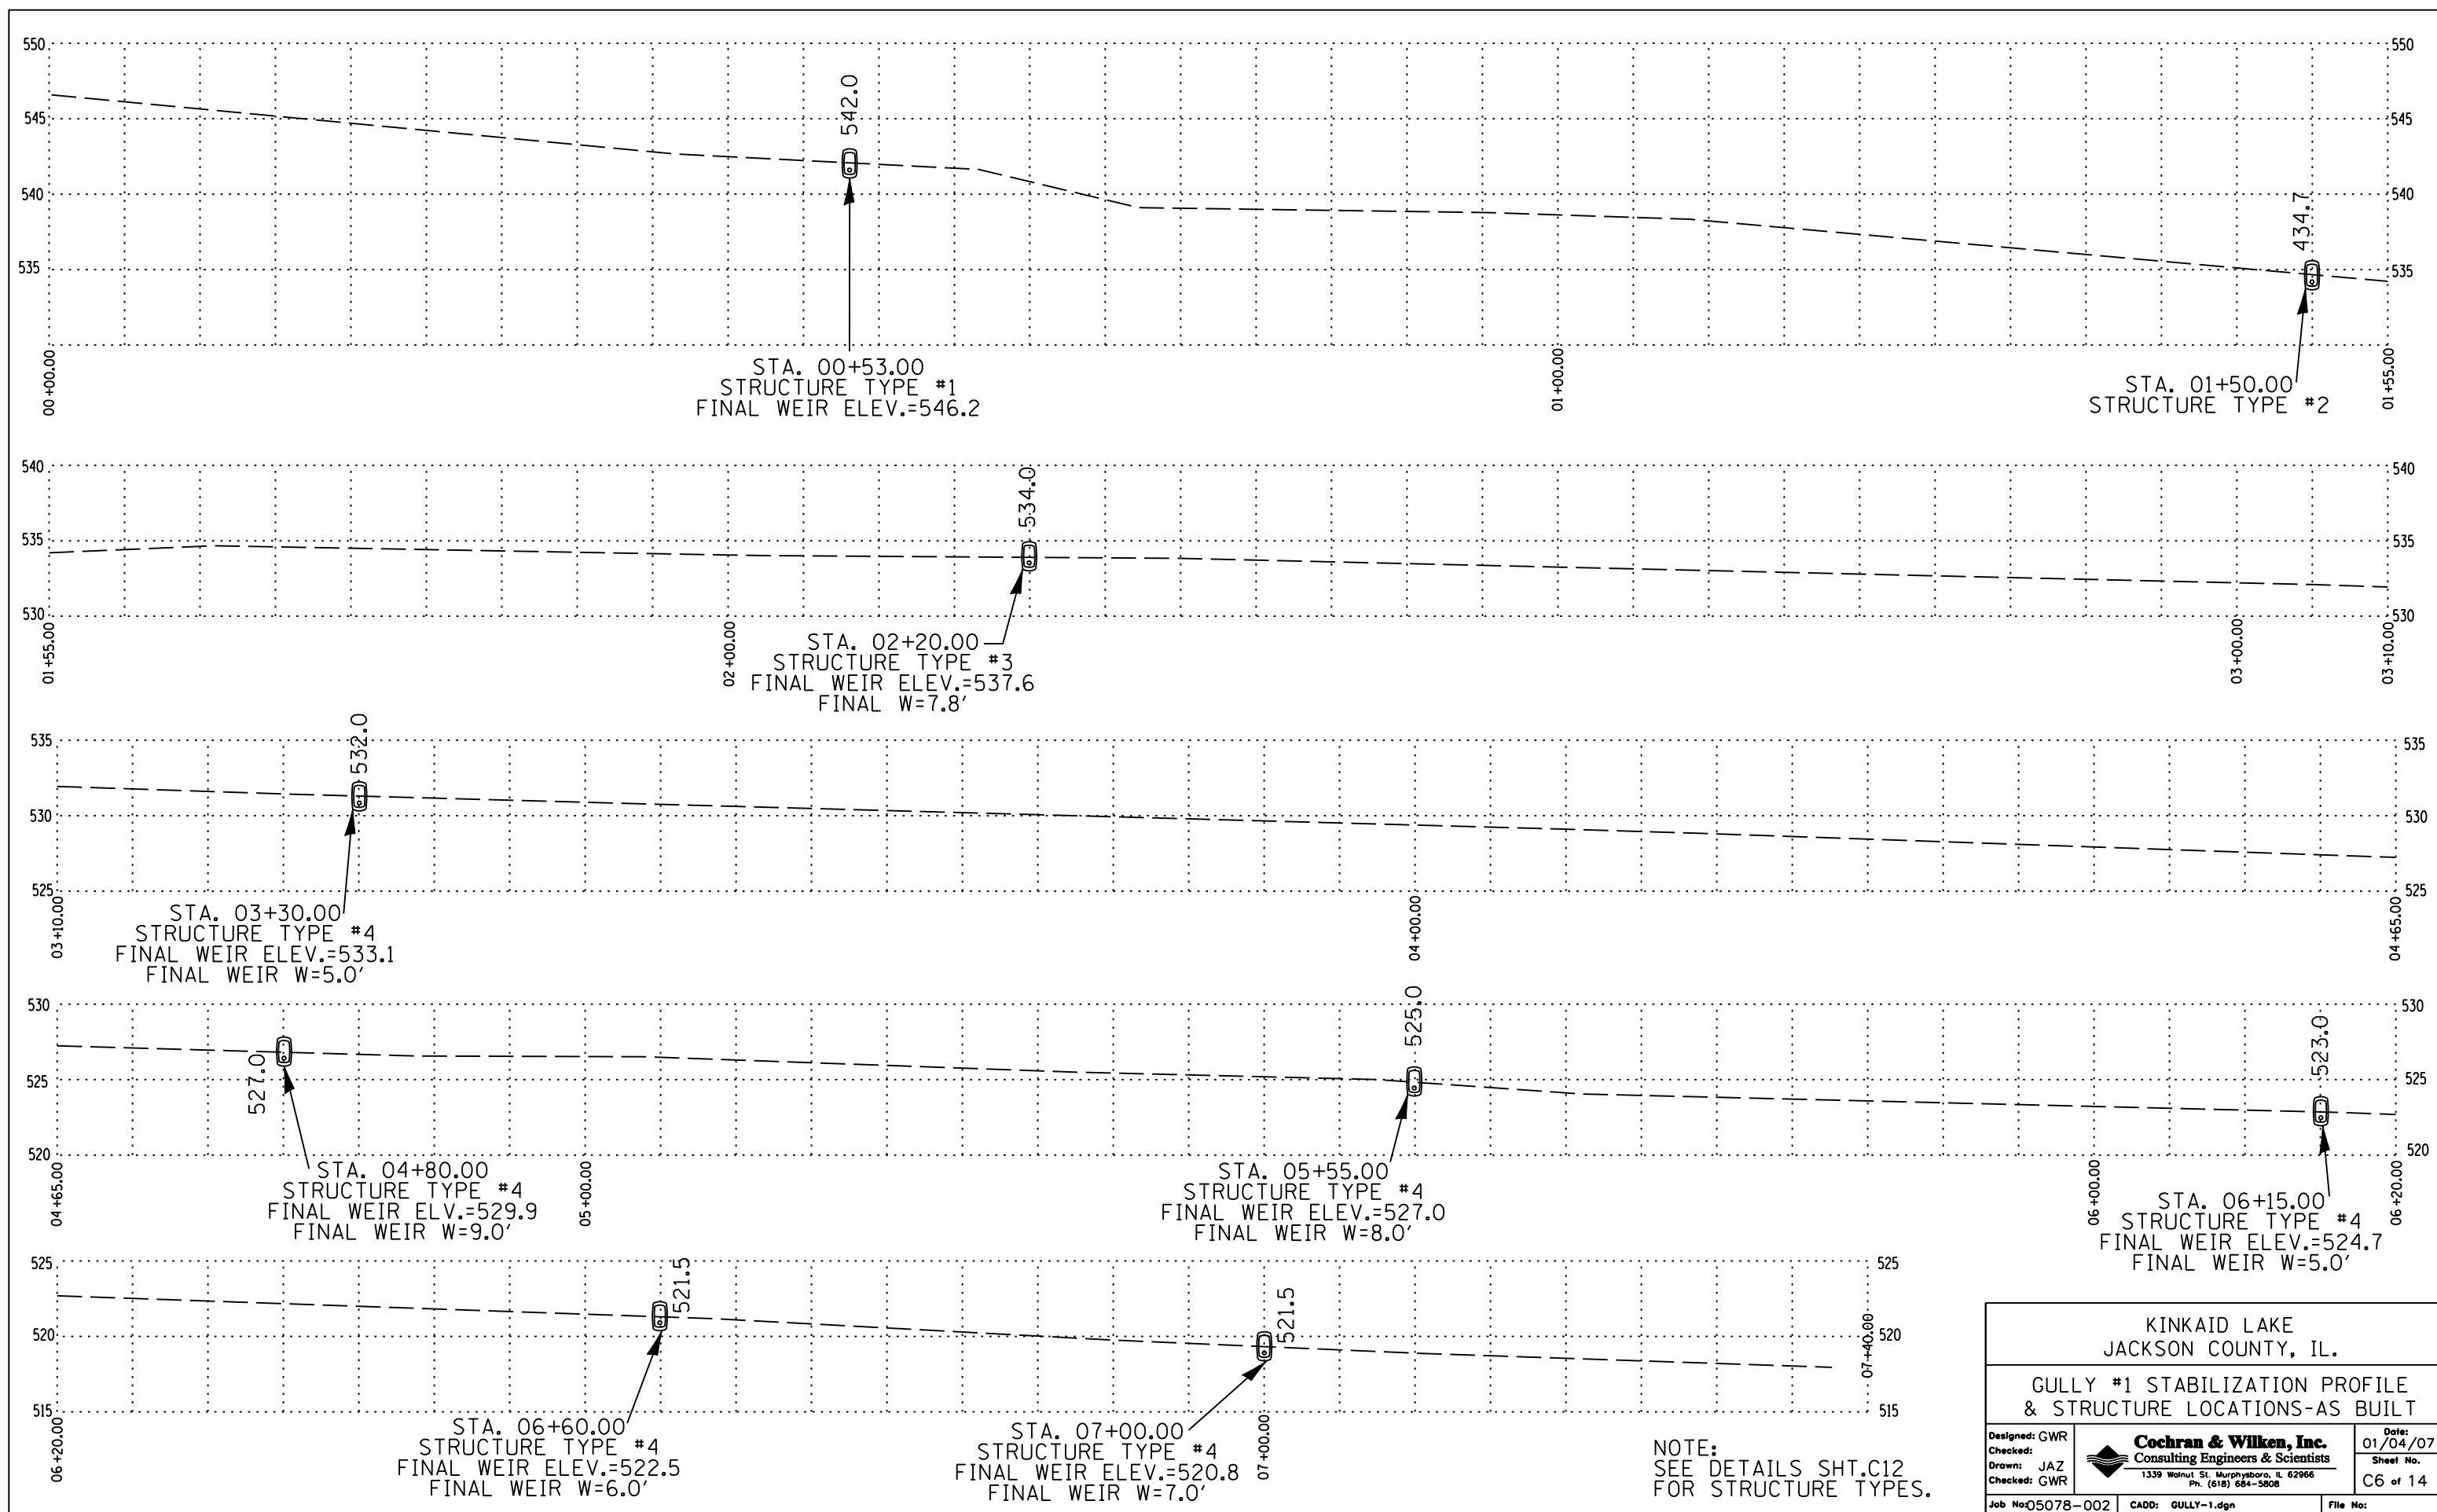

KINKAID LAKE JACKSON COUNTY, IL.		
GULLY #1 STABILIZATION PROFILE & STRUCTURE LOCATIONS-AS BUILT		
Designed: GWR Checked: JAZ Drawn: JAZ Checked: GWR	Cochran & Wilken, Inc. Consulting Engineers & Scientists 1339 Walnut St. Murphysboro, IL 62966 Ph. (618) 684-5808	Date: 01/04/07 Sheet No. C6 of 14
Job No: 05078-002	CADD: GULLY-1.dgn	File No:

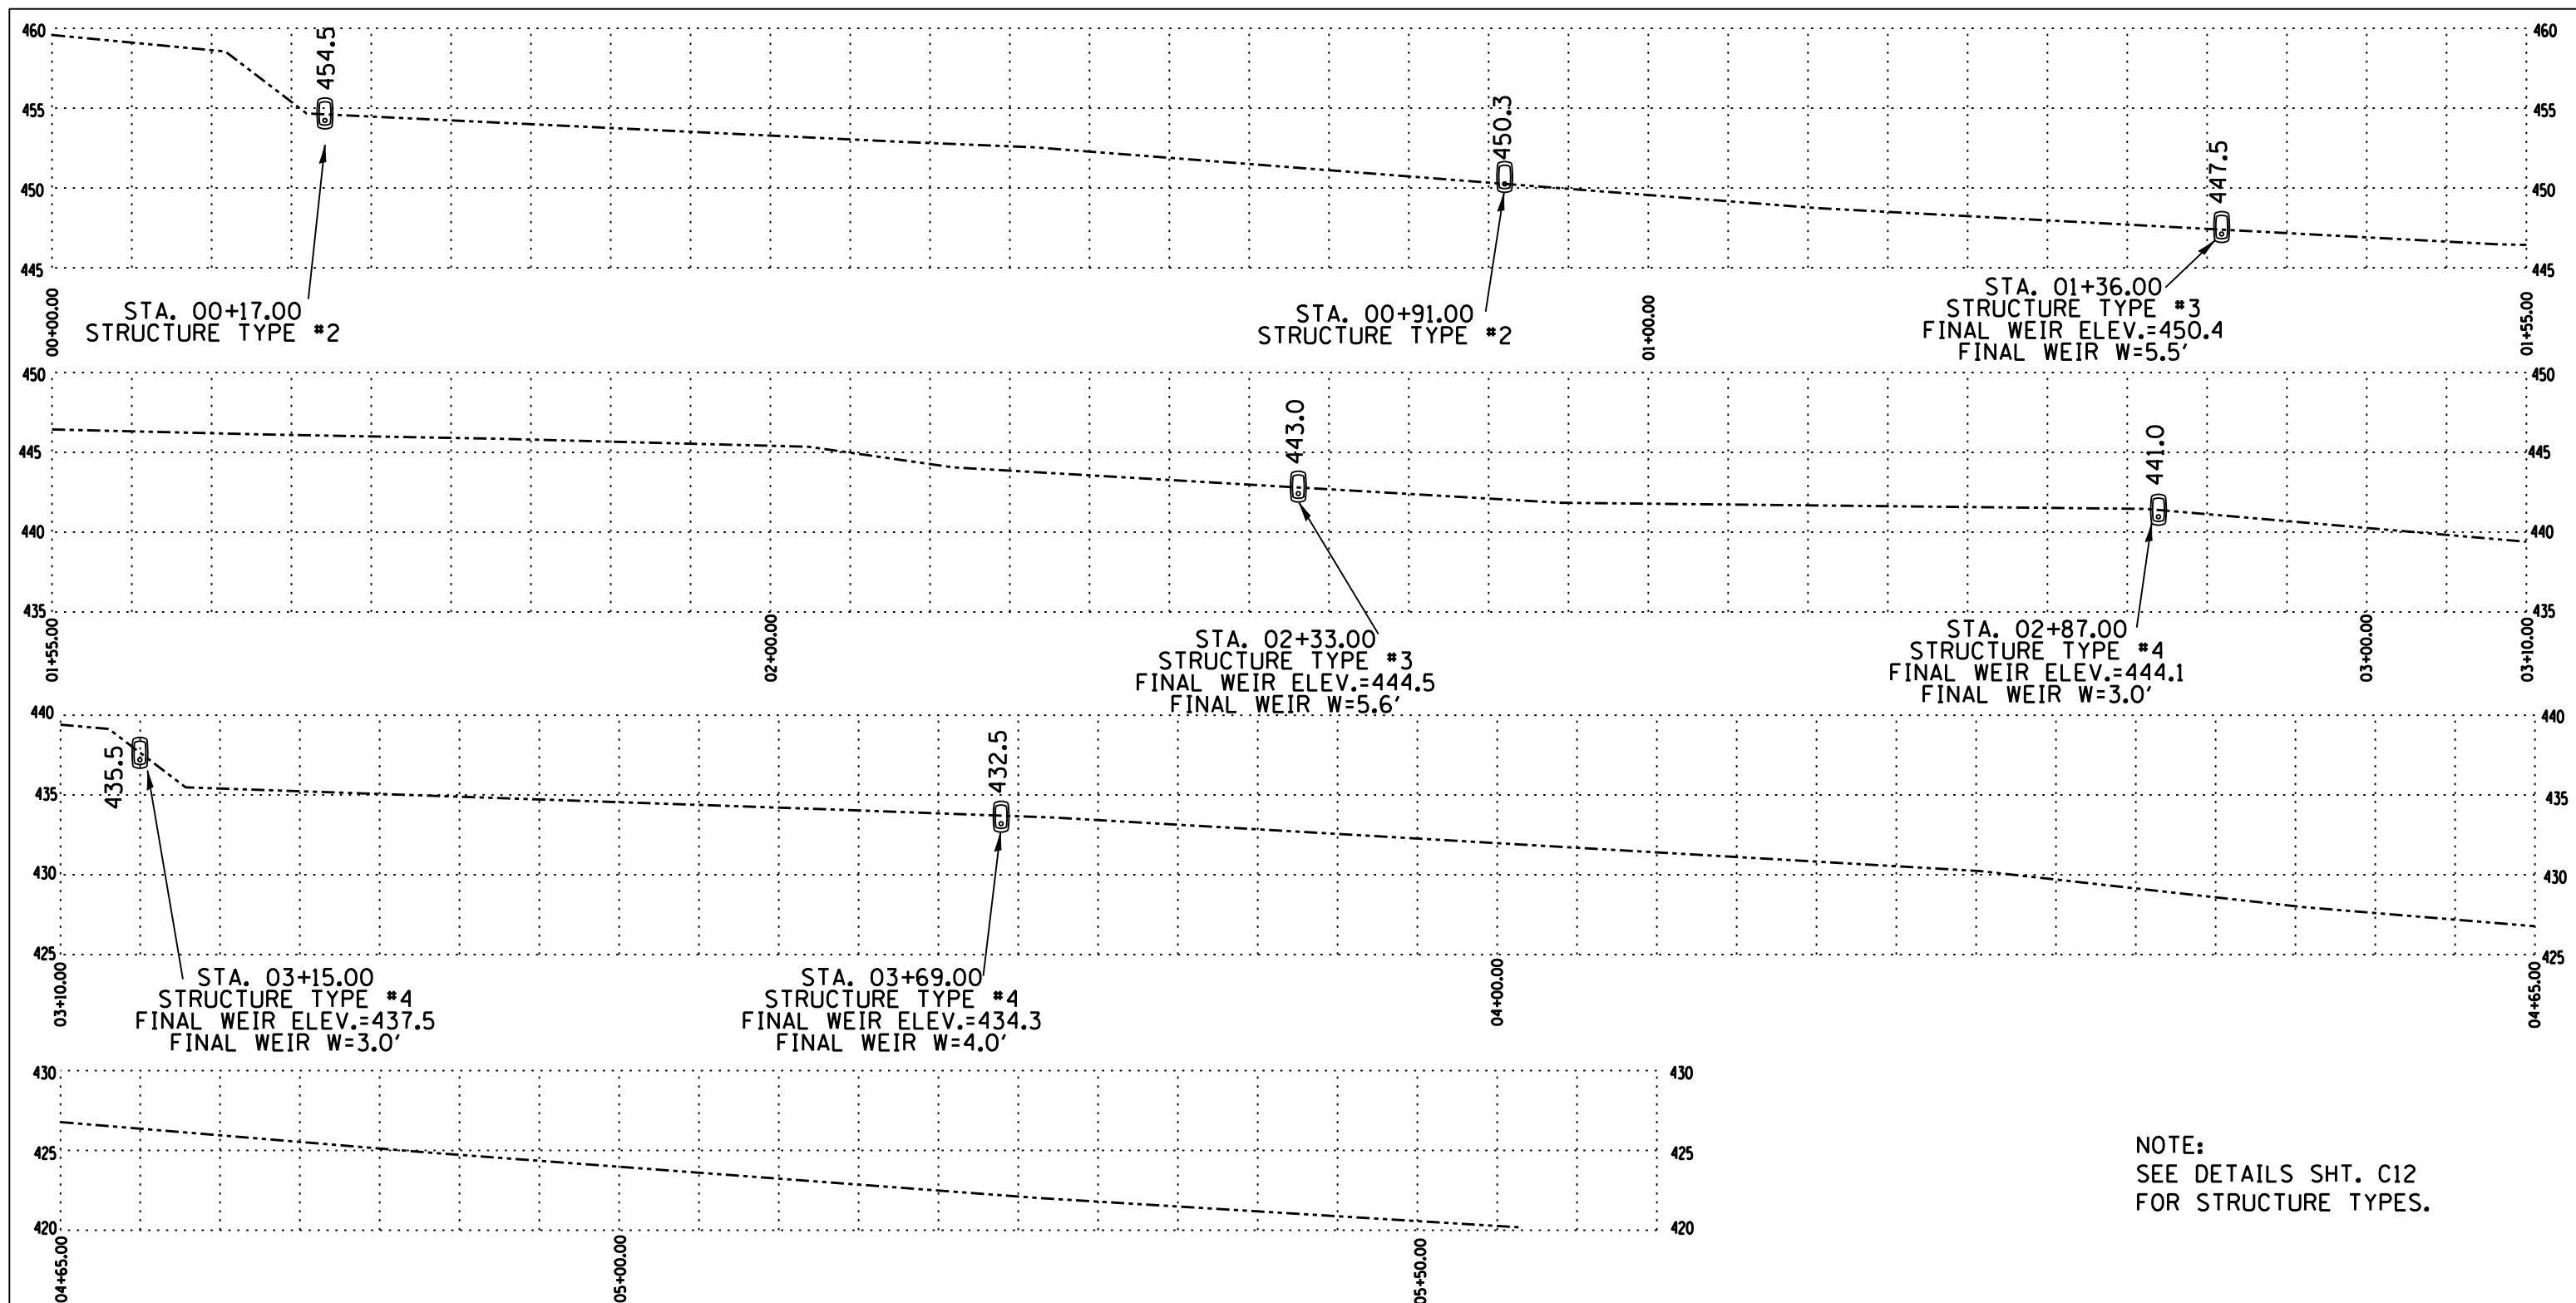

NOTE:
SEE DETAILS SHT. C12
FOR STRUCTURE TYPES.

KINKAID LAKE JACKSON COUNTY, IL.		
GULLY #2 STABILIZATION PROFILE & STRUCTURE LOCATIONS-AS BUILT		
Designed: GWR Checked: JAZ Drawn: JAZ Checked: GWR	Cochran & Wilken, Inc. Consulting Engineers & Scientists 1339 Walnut St. Murphysboro, IL 62966 Ph. (618) 684-5808	Date: 01/04/07 Sheet No. C9 of 14
Job No: 05078-002	CADD: GULLY-2.3d	File No:

STOCKADE POST STRUCTURE

12" (APPROX)

24"-36"

TREATED WOOD POST
4" to 6" DIA.

Diagram illustrating Profile 5, showing a cross-section of a gully flowline. The profile is labeled "PROFILE 5" and includes a vertical dimension of "15\".

STRUCTURE TYPE 3
POST-WEIR STRUCTURE

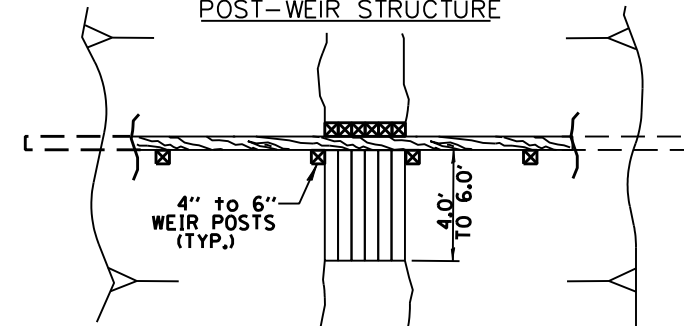


Diagram illustrating the cross-section of a weir structure, showing the weir posts, apron cutoff posts, and dimensions.

Key dimensions and components labeled:

- WEIR POSTS**: Vertical posts supporting the weir structure.
- W = ***: Width of the weir structure.
- 2.0' MIN. HORIZ. POST EMBEDMENT (TYP.)**: Minimum horizontal embedment of the weir posts.
- D = 12" or 18"**: Thickness of the weir structure.
- H = ***: Height of the weir structure.
- WEIR POSTS @ 5.0' O.C. MAX. DRIVE TO 36" MINIMUM DEPTH**: Spacing and depth requirement for the weir posts.
- APRON CUTOFF POSTS. DRIVE ALL POSTS 24" TO 36" DEEP**: Depth requirement for the apron cutoff posts.

6" x 12" WELDED WIRE


8.0'

INSERT FABRIC 6" TO 10" INTO BANK AT SIDE

4" to 6" POSTS, 4.0' C-C

PLAN

STRUCTURE TYPE 4
ROCK GRADE STABILIZATION STRUCTURE

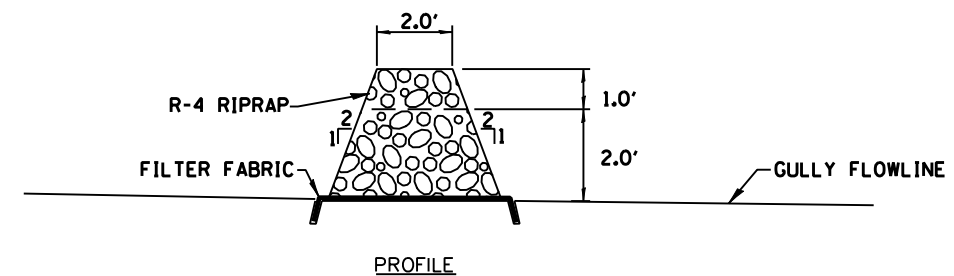

A cross-section diagram of a trench installation. The trench is filled with riprap, labeled "R-4 RIPRAP". The width of the riprap section is indicated as "W = *". The trench is lined with "FILTER FABRIC". On the right side, a label points to a section of the filter fabric: "INSERT FABRIC INTO 12\" TRENCH. TYPICAL BOTH SIDES". The entire diagram is captioned "CROSS SECTION" at the bottom.

...\\EROSION_CNTRL.dgn 8/14/2007 6:19:02 PM

ATTACHMENT 9
ABSTRACT FROM PRESENTATION BY JOHN SEVERSON

Wetland habitat enhancement and shoreline stabilization using rip rap breakwaters on Kinkaid Lake in southern Illinois

John Severson¹, Jack Nawrot², Michael Eichholz³, and David Fligor⁴

ABSTRACT

Reservoir shorelines are often impacted by severe erosion due to excessive slopes, saturated upland soils, and chronic wave action. Affected shorelines remain unvegetated, resulting in bare substrate, receding banks, and decreased water quality. Conventional bank rip rap effectively reduces erosion; however, habitat benefits are minimal. In contrast, rip rap placed ~10 – 40 feet from the eroded bank as a breakwater can reduce or eliminate wave energy, leading to habitat development through wetland and aquatic plant colonization.

Kinkaid Lake, a 2,750-acre reservoir in Jackson County, Illinois, is approximately 13 miles long southeast to northwest and supports ~80 miles of shoreline. The main lake body has a 3,280 – 5,740 feet fetch that can generate large waves. Wave action has eroded >27 miles of shoreline (~34%), forming shallow underwater shelves and vertical banks. Banks have receded up to ~3 feet/year due to wave erosion. Eroded banks have deposited more than 527 acre-feet of sediment within the basin. From 1999 – 2003, approximately 6,000 feet of rip rap breakwaters were installed on shelves of the severely eroded shorelines to reduce wave erosion and sediment deposition within the lake and promote bank stability and wetlands establishment.






Breakwaters were monitored from 2004-2006. Breakwaters reduced wave energy within the protected areas leading to bank/littoral stabilization and natural vegetation establishment. This contributed to water quality, aesthetics, and habitat. Increased vegetative cover (6x) and richness (10x) were observed at protected sites (121 spp.) compared to unprotected sites (12 spp.). Numerous wildlife species were observed in the newly established habitat including mammals, birds, fish, reptiles, amphibians, and various invertebrates.

¹ Graduate Research Assistant, Cooperative Wildlife Research Laboratory
Southern Illinois University, Carbondale, IL 62901 (618) 536-7766,
severson@siu.edu

² Senior Scientist, Cooperative Wildlife Research Laboratory
Southern Illinois University, Carbondale, IL 62901 (618) 536-7766,
jnawrot@siu.edu


³ Assistant Professor, Cooperative Wildlife Research Laboratory
Southern Illinois University, Carbondale, IL 62901 (618) 536-7766,
eichholz@siu.edu

⁴ Manager, Kinkaid-Reed's Creek Conservancy District, 1763 Water Plant Road,
Murphysboro, IL 62966 (618) 687-1722

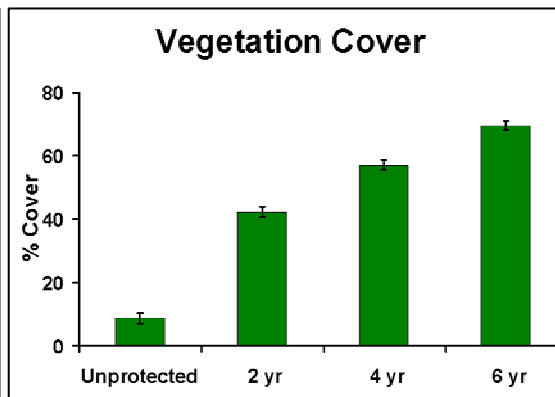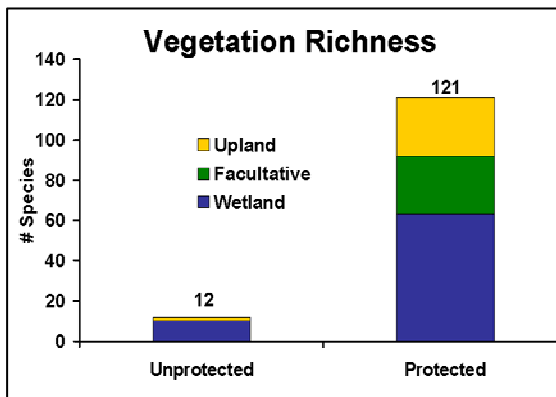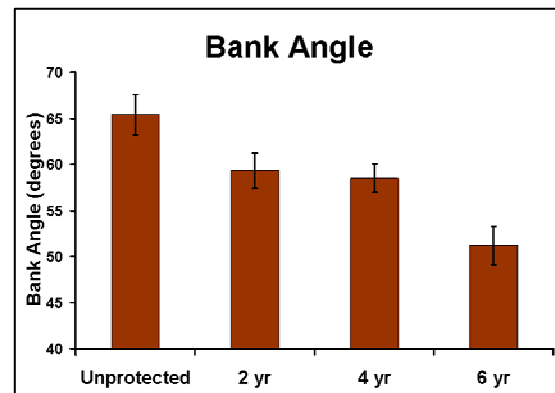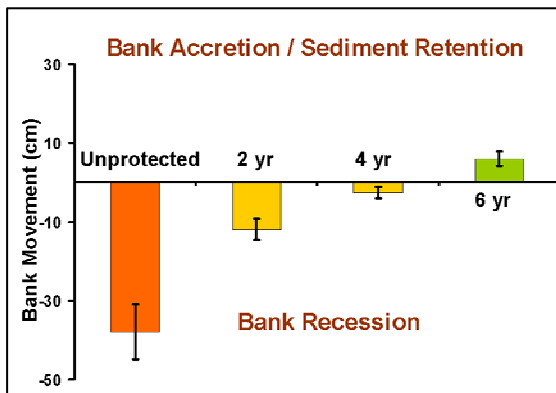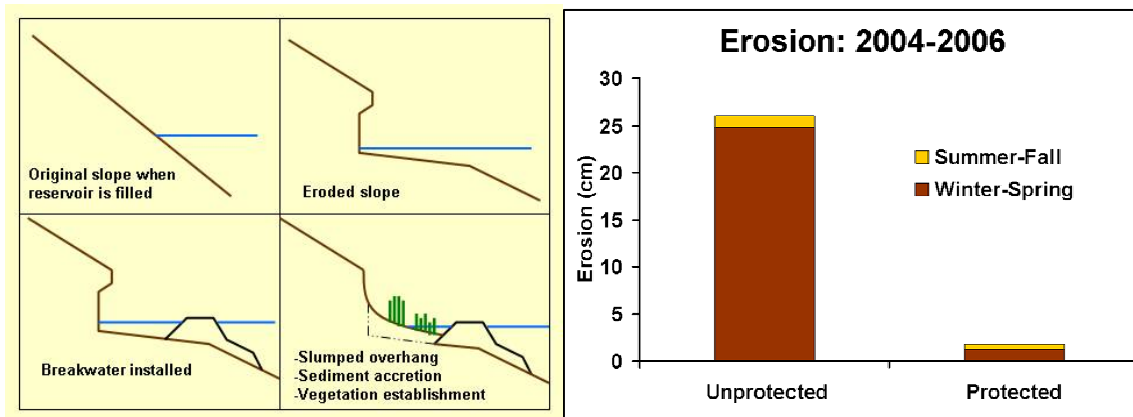

Protected Shoreline Succession



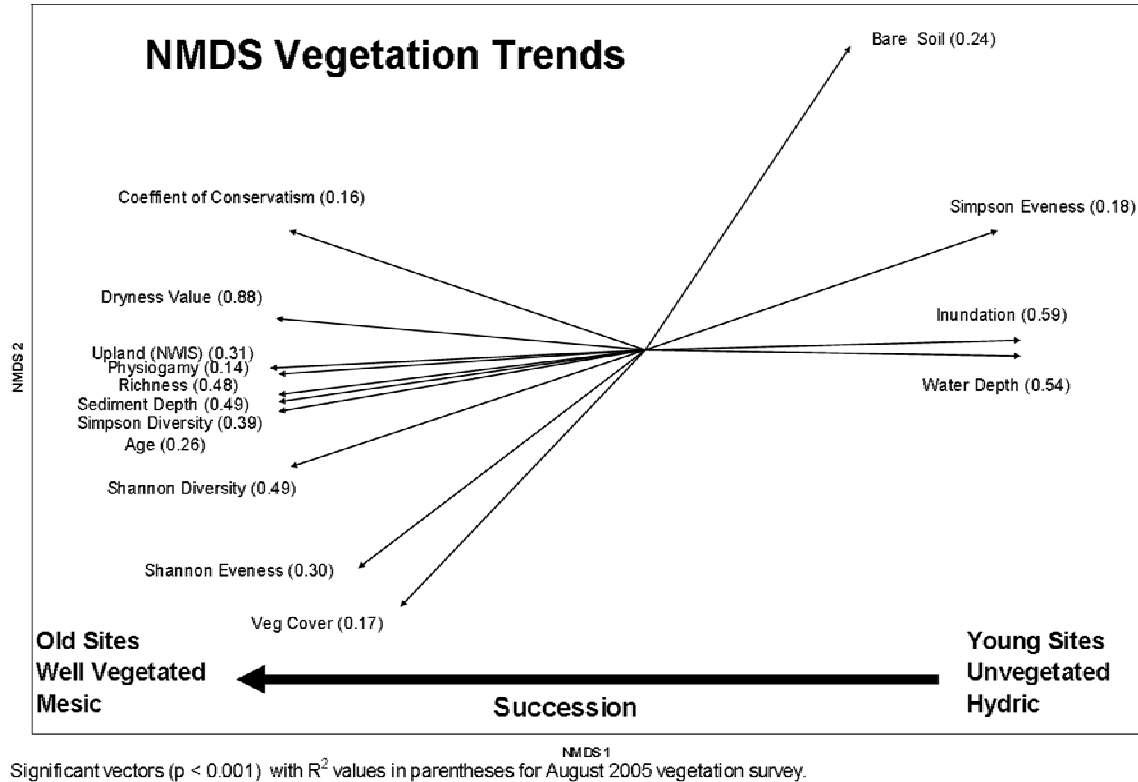

Benefits and Conclusions

Reduced erosion/wave energy
 Shoreline stabilization
 Natural plant colonization
 Succession of aquatic to terrestrial
 Wetland vegetation habitat
 Wetland wildlife habitat

Improved water quality
 Decreased sedimentation
 Improved aesthetics
 No upland disturbance with barge
 Overall healthier lake ecosystem

PERMISSION TO QUOTE

THIS IS A PROGRESS REPORT THAT MAY CONTAIN TENTATIVE OR PRELIMINARY FINDINGS. IT MAY BE SUBJECT TO FUTURE MODIFICATIONS AND REVISIONS. TO PREVENT THE ISSUING OF MISLEADING INFORMATION, PERSONS WISHING TO QUOTE FROM ANY OF THIS REPORT, TO CITE IT IN BIBLIOGRAPHIES, OR TO USE IT IN OTHER FORMS SHOULD FIRST OBTAIN PERMISSION FROM THE DIRECTOR OF THE COOPERATIVE WILDLIFE RESEARCH LABORATORY, SOUTHERN ILLINOIS UNIVERSITY, CARBONDALE, ILLINOIS 62901.